


STATE OF KANSAS  
STATE CORPORATION COMMISSION

WELL PLUGGING RECORD

Give All Information Completely  
Make Required Affidavit  
Mail or Deliver Report to  
Conservation Division  
State Corporation Comm.  
245 North Water  
Wichita, KS 67202

Harper County. Sec. 8 Twp. 35S Rge. 5W E/W  
Location as "NE/CNW $\frac{1}{2}$ SW $\frac{1}{4}$ " or footage from lines 150W - 150S of C NW SW  
Lease Owner Robinson Oil Company  
Lease Name Cink "A" Well No. #1  
Office Address 300 W. Douglas, Suite 737, Wichita, KS 67202  
Character of Well (Completed as Oil, Gas or Dry Hole) Dry Hole  
Date Well completed December 30, 1981  
Application for plugging filed December 30, 1981  
Application for plugging approved December 30, 1981  
Plugging commenced 1:30 a.m. 19  
Plugging completed 2:30 a.m. 19  
Reason for abandonment of well or producing formation D & A  
If a producing well is abandoned, date of last production none 19  
Was permission obtained from the Conservation Division or its agents before plugging was commenced? yes

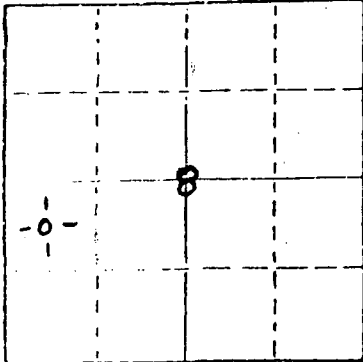

Locate well correctly on above Section Flat

Name of Conservation Agent who supervised plugging of this well Maurice Leslie, Nashville, KS  
Producing formation X Depth to top X Bottom X Total Depth of Well 4772'  
Show depth and thickness of all water, oil and gas formations.

OIL, GAS OR WATER RECORDS

CASING RECORD

FORMATION	CONTENT	FROM	TO	SIZE	PUT IN	PULLED OUT
				8 5/8"	264'	none

Describe in detail the manner in which the well was plugged, indicating where the mud fluid was placed and the method or methods used in introducing it into the hold. If cement or other plugs were used, state the character of same and depth placed, from \_\_\_\_\_ feet to \_\_\_\_\_ feet for each plug set.

- Ran 60 sacks at 700'
- 40 sacks at 235'
- 10 sacks at 40' Bridge Plug
- 10 sacks in Rat Hole
- 5 sacks in Mouse Hole

(If additional description is necessary, use BACK of this sheet)

Name of Plugging Contractor State Corporation Commission of Kansas

STATE OF KANSAS COUNTY OF SEDGWICK, ss.  
Ray Williams (employee of owner) or (owner or operator)  
of the above-described well, being first duly sworn on oath, says: That I have knowledge of the facts, statements, and matters herein contained and the log of the above-described well as filed and that the same are true and correct. So help me God.


(Signature)

RAY WILLIAMS

(Address)

SUBSCRIBED AND SWORN TO before me this 4th day of January, 1982

My commission expires

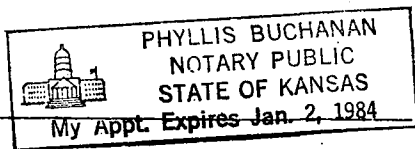

Phyllis Buchanan  
PHYLLIS BUCHANAN

Notary Public.

RECEIVED  
STATE CORPORATION COMMISSION

JAN - 6 1982  
CONSERVATION DIVISION  
Wichita Kansas

FIELD REPORT

DATE. 1-19-82  
OPERATOR. Robinson Oil Co.  
LEASE. Cink "A" #1  
LOCATION. SEC. 8 . TWP. 35 . RGE. 5W  
COUNTY. Harper (NW-SW)

X			

REMARKS. (WHAT WAS SAID OR SEEN).

Rat Hole, Mouse Hole and Surface Hole was open

Cemented W/3 yards of REDI MIX

Was on location from 9:00AM to 1:00PM waiting on cement.

Job was completed @ 2:00PM 1-20-82

Cemented by H.I. Grade REDI Mix Anthony, Ks

RECEIVED

STATE CORPORATION COMMISSION

FOR THE STATE.

*M. D. [Signature]*

JAN 25 1982

CONSERVATION DIVISION  
Wichita Kansas

MAKE (2) TWO COPIES, KEEP ONE AND SEND ORIGINAL TO: KCC 200 COLORADO DERBY BLDG. WICHITA KANSAS 67202