


Give All Information Completely  
Make Required Affidavit  
Mail or Deliver Report to:  
Conservation Division  
State Corporation Commission  
211 No. Broadway  
Wichita, Kansas

WELL PLUGGING RECORD

NORTH

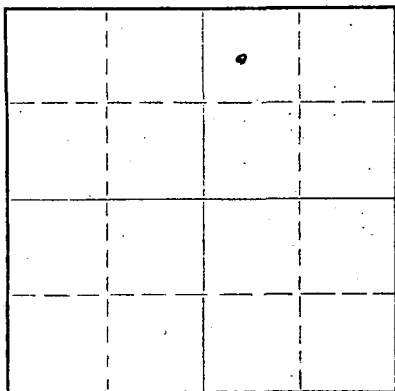

Locate well correctly on above  
Section Plat

Harper County, Sec. 18 Twp. 35S Rge. (E) 5 (W)

Location as "NE/CNW/SW" or footage from lines Ctr-NW-NE  
Lease Owner Texaco Inc.  
Lease Name C. J. Cink Well No. 1  
Office Address 614 Bitting Bldg., Wichita, Kansas  
Character of Well (completed as Oil, Gas or Dry Hole) Dry Hole  
Date well completed October 3, 1961 19  
Application for plugging filed Plugged by rotary 19  
Application for plugging approved Yes-October 3, 1961 19  
Plugging commenced October 3 19 61  
Plugging completed October 3 19 61  
Reason for abandonment of well or producing formation Dry Hole

If a producing well is abandoned, date of last production \_\_\_\_\_ 19  
Was permission obtained from the Conservation Division or its agents before plugging was commenced? Yes

Name of Conservation Agent who supervised plugging of this well M. H. Hollis  
Producing formation Dry Depth to top \_\_\_\_\_ Bottom \_\_\_\_\_ Total Depth of Well 5538 Feet  
Show depth and thickness of all water, oil and gas formations.

OIL, GAS OR WATER RECORDS

CASING RECORD

FORMATION	CONTENT	FROM	TD	SIZE	PUT IN	PULLED OUT
	Shale			8-5/8"	335	None

Describe in detail the manner in which the well was plugged, indicating where the mud fluid was placed and the method or methods used in introducing it into the hole. If cement or other plugs were used, state the character of same and depth placed, from \_\_\_\_\_ feet to \_\_\_\_\_ feet for each plug set.

TD 5538 Well was plugged as follows: From 5538 to 330 with heavy mud; pushed plug to 330'; from 330 to 280' with 20 sacks cement; from 280' to 40' with heavy mud; pushed plug to 40'; from 40' to bottom cellar with 15 sacks cement; plugged rat hole with 5 sacks cement.

RECEIVED  
STATE CORPORATION COMMISSION  
NOV 13 1961  
CONSERVATION DIVISION  
Wichita, Kansas

(If additional description is necessary, use BACK of this sheet)  
Name of Plugging Contractor Prime Drilling Company  
Address 814 Union Center Building, Wichita, Kansas


STATE OF Kansas, COUNTY OF Sedgwick, ss.  
F. E. Anderson (employee of owner) or (owner or operator) of the above-described well, being first duly sworn on oath, says: That I have knowledge of the facts, statements, and matters herein contained and the log of the above-described well as filed and that the same are true and correct. So help me God.

(Signature) F. E. Anderson  
614 Bitting Bldg., Wichita, Kansas  
(Address)

SUBSCRIBED AND SWORN to before me this 10 day of October, 19 61

My commission expires June 20, 1964

Notary Public.

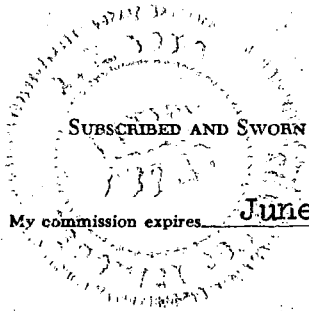


WELL LOG BUREAU--KANSAS GEOLOGICAL SOCIETY  
508 East Murdock, Wichita, Kansas

Company- TEXACO, INC.  
Farm- C. J. Cink No. 1

SEC. 18 T. 35 R. 5W  
C NW NE

Total Depth. 5538'  
Comm. 8-26-61 Comp. 10-1-61  
Shot or Treated.  
Contractor. Prime Drlg. Co.  
Issued. 2-10-62

County Harper  
KANSAS

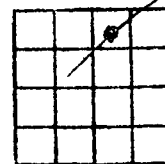

CASING:  
8 5/8" 335' cem w/225 sx.

Elevation. 1244' KB

Production. Dry

Figures Indicate Bottom of Formations.

sand & shale	336		
shale	1015	TOPS: SCOUT	
Anhydrite & shale	1175	Reebner	3214
shale & shell	1300	Douglas	3236
shale	1400	Stalnaker	3588
shale & shells	1555	Lower Stalnaker	3657
shale & lime	1675	Kansas City	3938
cherty lime	1795	Cot. Cr.	3956
shale & lime	2215	Kansas City Ln.	4008
shale	2365	Marmaton	4288
shale & lime	2785	Cherokee	4423
lime & shale	3024	Mississippi	4647
shale & lime	3226	Kinderhook	5142
shale	3227	Viola	5220
shale & lime	3370	Simpson Sand	5275
lime & shale	3465	Arbuckle	5484
sandy shale & lime	3540		
shale & lime	3725		
sandy shale & lime	3788		
shale & lime	3980		
lime	4124		
shale	4138		
lime	4155		
lime & shale	4315		
lime	4352		
lime & shale	4555		
shale & lime	4655		
chert	4660		
lime	4883		
lime & chert	4900		
lime	5106		
shale	5190		
shale & lime	5227		
lime & shale	5272		
sand	5334		
lime & sandy shale	5340		
sand	5350		
shale & sand	5361		
sandy shale & lime	5391		
sand	5406		
sandy shale & lime	5438		
sand & lime	5441		
sand & shale	5470		
sandy shale & lime	5482		
Arbuckle	5488		
sand & shale	5504		
shale & sand strks	5533		
Arbuckle	5538	RTD	
Total Depth			