

STATE OF KANSAS
STATE CORPORATION COMMISSION

Form CP-4


WELL PLUGGING RECORD

Give All Information Completely
M~~ust~~ Required Affidavit
Mail or Deliver Report to:
Conservation Division
State Corporation Commission
211 No. Broadway
Wichita, Kansas

Saline County. Sec. 4 Twp. 16S Rge. 1W (K) (W)

Location as "NE/CNW/SW" or footage from lines NW NW SW
Lease Owner Francis M. Raymond
Lease Name Karber Well No. 1
Office Address 410 Fourth Nat'l Bank Bldg., Wichita, Kansas
Character of Well (completed as Oil, Gas or Dry Hole) Dry Hole
Date well completed November 8, 19 58
Application for plugging filed November 8, 19 58
Application for plugging approved November 8, 19 58
Plugging commenced November 8, 19 58
Plugging completed November 8, 19 58
Reason for abandonment of well or producing formation _____

NORTH

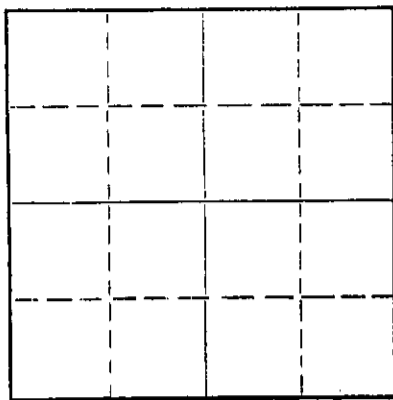

Locate well correctly on above
Section Plat

If a producing well is abandoned, date of last production _____ 19____
Was permission obtained from the Conservation Division or its agents before plugging was commenced? Yes

Name of Conservation Agent who supervised plugging of this well Ruel Durkett
Producing formation _____ Depth to top _____ Bottom _____ Total Depth of Well 2710' Feet
Show depth and thickness of all water, oil and gas formations.

OIL, GAS OR WATER RECORDS

CASING RECORD

FORMATION	CONTENT	FROM	TO	SIZE	PUT IN	PULLED OUT

Describe in detail the manner in which the well was plugged, indicating where the mud fluid was placed and the method or methods used in introducing it into the hole. If cement or other plugs were used, state the character of same and depth placed, from _____ feet to _____ feet for each plug set.

Tore down rig, plugged hole, racked out rig. Filled hole to 190'
with mud. Set firm bridge with 1/4 sacks hulls and 20 sacks cement.
Filled hole to 40', set bridge with 1/4 sacks hulls and 10 sacks cement.
Bridged out rate hole with 25 sacks cement.

RECEIVED
STATE CORPORATION COMMISSION

JAN 24 1963

CONSERVATION DIVISION
Wichita, Kansas

(If additional description is necessary, use BACK of this sheet)

Name of Plugging Contractor Raymond Oil Company, Inc.
Address 410 Fourth National Bank Bldg. Wichita, Kansas

STATE OF Kansas, COUNTY OF Sedgwick, ss.
Chas. W. Raymond (employee of owner) or (owner or operator) of the above-described well, being first duly sworn on oath, says: That I have knowledge of the facts, statements, and matters herein contained and the log of the above-described well as filed and that the same are true and correct. So help me God.

(Signature) Chas W Raymond
410 Fourth National Bank Building
(Address)

SUBSCRIBED AND SWORN to before me this 17th day of January, 19 63

My commission expires July 9, 1966

Barbara A. Kennedy
Notary Public

