


Give All Information Completely
Make Required Affidavit
Mail or Deliver Report to:
Conservation Division
State Corporation Commission
800 Bittling Building
Wichita, Kansas

OR
FORMATION PLUGGING RECORD

Strike out upper line
when reporting plug-
ging off formations.

NORTH

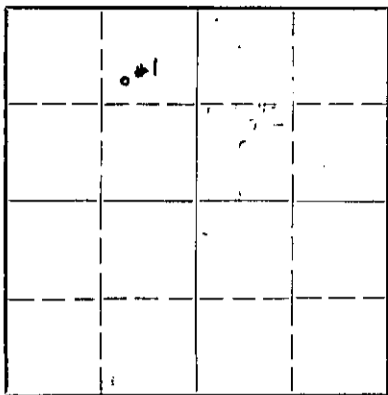

Locate well correctly on above
Section Plat

Saline County. Sec. 5 Twp. 16S. Rge. (E) 1W (W)
Location as "NE $\frac{1}{4}$ NW $\frac{1}{4}$ SW $\frac{1}{4}$ " or footage from lines SW $\frac{1}{4}$ NE $\frac{1}{4}$ NW $\frac{1}{4}$
Lease Owner Flynn Oil Company
Lease Name Martin T. Heshel Well No. 1
Office Address 813 Thompson Building, Tulsa 3, Oklahoma
Character of Well (completed as Oil, Gas or Dry Hole) Dry hole
Date well completed October 27, 19 43
Application for plugging filed October 27, 19 43
Application for plugging approved November 5, 19 43
Plugging commenced October 31, 19 43
Plugging completed November 1, 19 43
Reason for abandonment of well or producing formation Dry hole

If a producing well is abandoned, date of last production - - - - - 19
Was permission obtained from the Conservation Division or its agents before plugging was com-
menced? Yes

Name of Conservation Agent who supervised plugging of this well Ruel Durkee
Producing formation - - - - - Depth to top - - - - - Bottom - - - - - Total Depth of Well 2663 Feet
Show depth and thickness of all water, oil and gas formations.


OIL, GAS OR WATER RECORDS

CASING RECORD

Formation	Content	From	To	Size	Put In	Pulled Out
Surface				10"	100'	none
Mississippi Lime	SSO	2621	2663			

Describe in detail the manner in which the well was plugged, indicating where the mud fluid was placed and the method or methods used in introducing it into the hole. If cement or other plugs were used, state the character of same and depth placed, from - - - - - feet to - - - - - feet for each plug set.
Ran 24 stands drill pipe in hole and pumped hole full of mud.
Set wood plug at 90 feet and cemented with 15 sacks cement.
Also set wood plug and cemented with 5 sacks cement 3 feet below surface.

PLUGGING
FILE SET 5-16R1W
BOOK PAGE 9-7 LINE 17

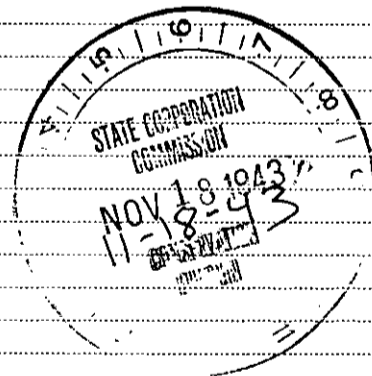

(If additional description is necessary, use BACK of this sheet.)

Correspondence regarding this well should be addressed to Flynn Oil Company
Address 813 Thompson Building, Tulsa 3, Oklahoma

STATE OF OKLAHOMA COUNTY OF Tulsa, ss.
Olney F. Flynn (employee of owner) or (owner or operator) of the above-described well,
being first duly sworn on oath, says: That I have knowledge of the facts, statements, and matters herein contained and the log of the above-
described well as filed and that the same are true and correct. So help me God.

(Signature) Olney F. Flynn
813 Thompson Building, Tulsa, Oklahoma
(Address)

SUBSCRIBED AND SWORN TO before me this 16th day of November, 1943.
Lula Grant Reese
Notary Public.

My commission expires 2-23-46



15-169-19117-0000

WELL LOG

HESHER #1

OPERATOR: Flynn Oil Company et al
CONTRACTOR: Holm Drilling Company

LOCATION: SWNE $\frac{1}{4}$ NW $\frac{1}{4}$ Sec. 5-16S-1W, Saline County, Kansas

COMMENCED: October 13, 1943

COMPLETED: October 30, 1943

TOTAL DEPTH: 2663'

CASING RECORD: 10" set at 100' and cemented with 90 sacks of cement
by Halliburton Cementing Company

FORMATIONS	DEPTH
Surface Clay and Shale Blue	70
Shale	101
Shale, Gyp and Lime Shells	185
Gyp, Lime and Shale	340
Lime and Shale	485
Shale and Lime Shells	505
Shale and Shells	550
Lime, Brown Hard	570
Lime, Gray Hard	640
Lime	730
Shale and Shells	870
Shale and Lime Shells	1075
Shale and Lime	1220
Shale and Lime Shells	1450
Lime, Broken	1600
Shale and Lime Shells	1675
Lime, Gray Hard	1715
Lime, Light Medium	1820
Shale, Gray	1840
Shale and Lime Shells	1940
Lime and Shale	2060
Lime, Light Hard	2075
Shale and Lime Shells	2160
Lime, Gray Hard	2190
Shale and Shells	2200
Lime, Gray Hard	2250
Shale and Shells	2265
Lime, Gray Hard	2275
Shale and Lime Shells	2290
Lime, Gray Hard	2330
Lime, Gray	2335
Lime, Shale Breaks	2385
Lime, Broken	2440
Lime, Gray	2450
Shale and Lime Shells	2590
Shale and Shells	2616
Lime	2635
Lime, Light	2645
Lime	2663 T.D.

3-16-48

I hereby certify the above is a true and correct copy of the log of the Heshar #1 well.

HOLM DRILLING COMPANY

By

J. C. Hatfield
J. C. Hatfield

PLUGGING
FILE SEC 5 T 16 R 14
BOOK PAGE 97 LINE 17