


WELL PLUGGING RECORD

STATE OF KANSAS
STATE CORPORATION COMMISSION
Give All Information Completely
Make Required Affidavit
Mail or Deliver Report to:
Conservation Division
State Corporation Commission
211 No. Broadway
Wichita, Kansas

Saline County, Sec. 5 Twp. 16 Rge. 1 (E) W (W)

Location as "NE/CNW/SW" or footage from lines SW SE SW
Lease Owner F. S. Williams
Lease Name Hasher Well No. 2
Office Address 202 Maltby Bldg., McPherson Kansas
Character of Well (completed as Oil, Gas or Dry Hole) Oil Well
Date well completed July 1 19 57
Application for plugging filed July 19 19 57
Application for plugging approved July 22 19 57
Plugging commenced July 29 19 57
Plugging completed Aug. 2 19 57
Reason for abandonment of well or producing formation Non-Commercial

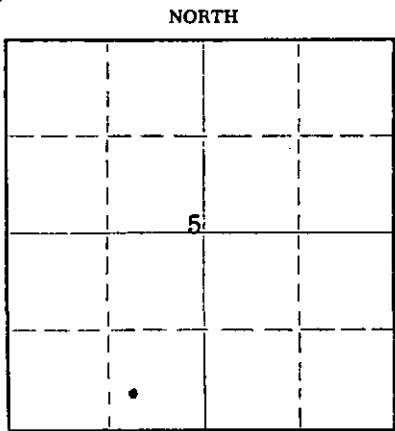

Locate well correctly on above Section Plat

If a producing well is abandoned, date of last production July 1 19 57
Was permission obtained from the Conservation Division or its agents before plugging was commenced? Yes

Name of Conservation Agent who supervised plugging of this well Ruel Durkee
Producing formation Mississippian Depth to top 2671' Bottom 2706' Total Depth of Well 2706 Feet
Show depth and thickness of all water, oil and gas formations.

OIL, GAS OR WATER RECORDS

CASING RECORD

FORMATION	CONTENT	FROM	TO	SIZE	PUT IN	PULLED OUT
Chat	Water	2671	2706	8 5/8"	130'	None
				5 1/2"	2671'	2409'

Describe in detail the manner in which the well was plugged, indicating where the mud fluid was placed and the method or methods used in introducing it into the hole. If cement or other plugs were used, state the character of same and depth placed, from feet to feet for each plug set.

Set rock plug from 2706' to 2660'

Dumped 6 sack cement plug at 2660'

Shot 5 1/2" casing loose at 2409' and pulled same.

Mudded hole.

Set rock bridge at 135' and dumped 15 sack cement plug on top of same.

Mudded hole to 20' - Set Rock bridge at 20'

Dumped 5 sack cement plug from 20' to bottom of cellar.

Job completed.

(If additional description is necessary, use BACK of this sheet)
Name of Plugging Contractor Wiggins & Lamb Pipe Pulling Co.
Address P.O. Box 191, McPherson Kansas

STATE OF KANSAS COUNTY OF MCPHERSON ss.
F. S. WILLIAMS (employee of owner) or (owner or operator) of the above-described well, being first duly sworn on oath, says: That I have knowledge of the facts, statements, and matters herein contained and the log of the above-described well as filed and that the same are true and correct. So help me God.

(Signature) F. S. Williams
By 746 McPherson, Kans.
(Address)

SUBSCRIBED AND SWORN TO before me this 6TH day of AUGUST, 1957

My commission expires 9-14-1958

Roger Nordstrom Notary Public.

PLUGGING
FILE SEC 5 T 16 R 1W
BOOK PAGE 28 LINE 3

RECEIVED
STATE CORPORATION COMMISSION
8-8-57
AUG 8 1957
CONSERVATION DIVISION
Wichita, Kansas

WELL LOG

Company: F. S. WILLIAMS

Sec. 5 Twp. 16S Rge. 1W

Farm: HESHER No. 1

Location: SW SE SW

Saline County, Kansas

Commenced: 4/22/57

Completed: 4/28/57

Total Depth: 2672

Contractor: Greenland Drilling Company

Casing: 8-5/8" 130'
5-1/2" 2671'

Elevation:

Production:

Figures Indicate Bottom of Formations

30	Rock & clay	TOPS:
130	Shale & lime	
290	Lime & shale w/red bed streaks	
500	Lime	
670	Lime w/shale	
685	Shale w/lime streaks	
1095	Shale & lime	
1195	Shale	
1755	Shale & lime	
1895	Lime & shale	
1972	Shale & lime	
2540	Lime & shale	
2654	Shale & lime	
2672	Mississippi	
2672	RFD	

CABLE TOOLS

Measurements from Kelly Bushings

April 2:

2672- Shoe
 2672-2674 $\frac{1}{2}$ Shale black and dolomite
 2674 $\frac{1}{2}$ -2678 Dolomite gray and a lot of pyrite
 2678-2681 $\frac{1}{2}$ Dolomite white with slight stain
 Very small show oil (dead)
 2681 $\frac{1}{2}$ -2683 Dolomite white no stain.
 2683-2686 Dolomite good stain show oil
 Acidized 500 gals 16BO 50 BWPD
 Put on pump--no good

Drilled Deeper.

2686-2706 Increase water, no oil

Dry and abandoned.

STATE OF KANSAS, COUNTY OF SEDGWICK, ss:

I, Oscar Bridge, of the Greenland Drilling Company, upon oath state that the above and foregoing is a true and correct copy of the log of the #1 Heshier well.

Oscar Bridge
 Oscar Bridge, Vice-President

Subscribed and sworn to before me this 10th day of May, 1957.

Verdina B. Rutledge
 Verdina B. Rutledge, Notary Public

My commission expires March 15, 1960.

RECEIVED
 STATE CORPORATION COMMISSION

AUG 8 1957

CONSERVATION DIVISION
 Wichita, Kansas

RECEIVED
 STATE CORPORATION COMMISSION

JUL 16 1957

CONSERVATION DIVISION
 Wichita, Kansas

PLUGGING
 FILE SEC. 5 T. 16 R. 1W
 BOOK PAGE 28 LINE 3