


WELL PLUGGING RECORD

Give All Information Completely
Make Required Affidavit
Mail or Deliver Report to:
Conservation Division
State Corporation Commission
211 No. Broadway
Wichita, Kansas

Saline County, Sec. 5 Twp. 16 Rge. (E) 1 (W)

Location as "NE/CNW/SW" or footage from lines ~~SW-SE-SE~~ SW-SE-SE
Lease Owner F. S. Williams
Lease Name Ben Karber B hsc Well No. 1
Office Address Box 746, McPherson, Kansas
Character of Well (completed as Oil, Gas or Dry Hole) Dry hole
Date well completed April 16 1962
Application for plugging filed 1 4 1962
Application for plugging approved " 27 1962
Plugging commenced 6-25 1962
Plugging completed 6-27 1962
Reason for abandonment of well or producing formation _____

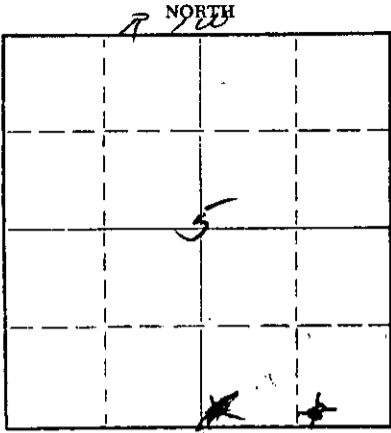

Locate well correctly on above Section Plat

If a producing well is abandoned, date of last production _____ 19____
Was permission obtained from the Conservation Division or its agents before plugging was commenced? yes

Name of Conservation Agent who supervised plugging of this well Gilbert Toman
Producing formation _____ Depth to top _____ Bottom _____ Total Depth of Well 2645 Feet
Show depth and thickness of all water, oil and gas formations.

OIL, GAS OR WATER RECORDS

CASING RECORD

FORMATION	CONTENT	FROM	TO	SIZE	PUT IN	PULLED OUT
<u>McPherson chert</u>	<u>Dry</u>	<u>2641</u>	<u>68</u>	<u>8 5/8"</u>	<u>130'</u>	<u>none</u>
				<u>5 1/2"</u>	<u>2644'</u>	<u>2379'</u>

Describe in detail the manner in which the well was plugged, indicating where the mud fluid was placed and the method or methods used in introducing it into the hole. If cement or other plugs were used, state the character of same and depth placed, from _____ feet to _____ feet for each plug set.

Sanded hole to 2630'-dumped 5 sks cement-
pulled casing-mudded to 165'-set 15' rock
bridge-dumped 25 sks cement-mudded to 35'
set 5' rock bridge-dumped 10 sks cement.

RECEIVED
STATE CORPORATION COMMISSION
JUL 16 1962
CONSERVATION DIVISION
Wichita, Kansas

RECEIVED
STATE CORPORATION COMMISSION
7-9-62
JUL 9 1962
CONSERVATION DIVISION
Wichita, Kansas

(If additional description is necessary, use BACK of this sheet.)
Name of Plugging Contractor R & D Casing Pulling Co. License #236
Address Box 572, Hutchinson, Kansas

STATE OF Kansas COUNTY OF McPherson, ss.
F. S. Williams (employee of owner) or (owner or operator) of the above-described well, being first duly sworn on oath, says: That I have knowledge of the facts, statements, and matters herein contained and the log of the above-described well as filed and that the same are true and correct. So help me God.

(Signature) F. S. Williams
McPherson, Ks.
(Address)

SUBSCRIBED AND SWORN TO before me this 6th day of July, 1962.

My commission expires 9-14-1962.
Roger H. Stinson Notary Public.

K

15169-00692.0000

W E L L R E C O R D

Lease: Karber "B" *lsc.* Well No. **3**

Location: *SW-SE-SE*
SE/4 SW/4 SE/4 Commenced: 4/4/62
Section 5-16S-1W
Saline County, Kansas Completed: 4/9/62

Operator: F. S. Williams
McPherson, Kansas

Contractor: Melland Drilling Co., Inc.
1111 North Main Street
Hutchinson, Kansas

Casing Record: 8-5/8" set at 130' with 95 sacks of cement.
5-1/2" set at 2644' with 40 sacks of cement.

FORMATION

LOG

Surface soil, clay & shale	45
Gypsum & shale	130
Lime	270
Lime & shale	770
Shale & shells	1225
Shale & lime	1505
Lime & shale	1780
Shale & shells	2025
Lime & shale	2315
Shale & shells	2585
Shale	2641
Mississippi Lime	2645

ROTARY TOTAL DEPTH

RECEIVED
STATE CORPORATION COMMISSION

JUL 9 1962

CONSERVATION DIVISION
Wichita, Kansas

Cable Tools

2645-2648 Dol wt gr. no show
2648-2650 Dol Sugary Sat. no fluid
2650-2653 Dol br. sugary pay no fluid
2653-2655 Dol. lm. saturated no fluid
2655-2656 Dol and lime lighter—formation tight—show free oil.
2656-2659 Dol. st Soft, no increase fluid
2659-2662 Dol. cherty, wt fine.
2662-2665 Dol. gr. chert wt. Slight stain
2665-2668 Dol. lt. chert wt, lime st and fine.
Bailer showed bottom hole water, increase fluid,
salt water.

Acidized with 2000 gals and 5000 gals no result

D & A

RECEIVED
STATE CORPORATION COMMISSION
JUL 16 1962
CONSERVATION DIVISION
Wichita, Kansas