


Give All Information Completely
Make Required Affidavit
Mail or Deliver Report to:
Conservation Division
State Corporation Commission
211 No. Broadway
Wichita, Kansas

WELL PLUGGING RECORD

NORTH

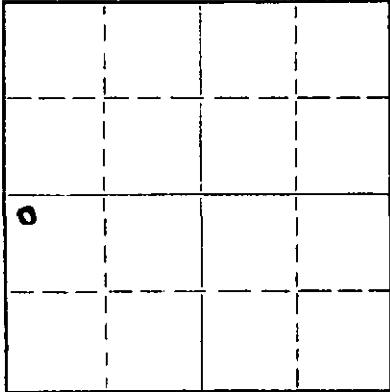

Locate well correctly on above
Section Plat

Saline County. Sec. 6 Twp. 16 Rge. (E) 1 (W)
Location as "NE/CNW*SW*" or footage from lines. NW NW SW
Lease Owner Frank Black
Lease Name Larson Well No. 1
Office Address Box 150 McPherson, Kansas
Character of Well (completed as Oil, Gas or Dry Hole) dry hole
Date well completed March 5, 19 66
Application for plugging filed " 19 66
Application for plugging approved " 19 66
Plugging commenced " 19 66
Plugging completed " 19 66
Reason for abandonment of well or producing formation dry hole

If a producing well is abandoned, date of last production _____ 19____
Was permission obtained from the Conservation Division or its agents before plugging was commenced? yes

Name of Conservation Agent who supervised plugging of this well Gilbert Toman
Producing formation _____ Depth to top _____ Bottom _____ Total Depth of Well 2751 Feet
Show depth and thickness of all water, oil and gas formations.

OIL, GAS OR WATER RECORDS

CASING RECORD

FORMATION	CONTENT	FROM	TO	SIZE	PUT IN	PULLED OUT
				10"	135	none

Describe in detail the manner in which the well was plugged, indicating where the mud fluid was placed and the method or methods used in introducing it into the hole. If cement or other plugs were used, state the character of same and depth placed, from _____ feet to _____ feet for each plug set.

heavy mud 2751' to 130'
wooden plug & 1/2sx hulls @ 130'
25sx cement on plug
heavy mud to 30'
wooden plug & 1/2sx hulls @ 30'
10sx cement on plug
surface soil 0' to 0'

RECEIVED
STATE CORPORATION COMMISSION
3-14-66
MAR 14 1966

CONSERVATION DIVISION
Wichita, Kansas

(If additional description is necessary, use BACK of this sheet)

Name of Plugging Contractor Melland Drilling Co., Inc.
Address Box 783 McPherson, Kansas

STATE OF Kansas COUNTY OF McPherson, ss.

Donald J. Melland (employee of owner) or (owner) of the above-described well, being first duly sworn on oath, says: That I have knowledge of the facts, statements, and matters herein contained and the log of the above-described well as filed and that the same are true and correct. So help me God.

(Signature) Donald J. Melland
Box 783, McPherson, Kansas
(Address)

SUBSCRIBED AND SWORN to before me this 8th day of March, 19 66

My commission expires December 23, 1967 John S. [Signature] Notary Public.

WELL RECORD

LEASE: Larson

WELL NO. 1

ELEVATION: 1325 RE

LOCATION: NW NW SW
Sec. 6-16-1W

COMMENCED: 2/26/66

COMPLETED: 3/5/66

OPERATOR: Frank Black

CONTRACTOR: Melland Drilling Company, Inc.
Post Office Box 783
McPherson, Kansas

CASING RECORD: 10" @ 135'/110sx

FORMATION	LOG
clay & shale	10
shale & shells	100
anhydrite	135
shale & shells	230
lime	610
lime & shale	700
shale & shells	884
shale	970
lime & shale	1339
shale	1588
shale & lime	2028
lime & shale	2131
shale & lime	2255
lime	2280
lime & shale	2665
shale & lime	2743
Mississippi	2751
RTD	2751
Sample Tops	
Lansing	2080
Mississippian	2717

FORMATION LOG


RECEIVED
STATE CORPORATION COMMISSION

MAR 14 1966

CONSERVATION DIVISION
Wichita, Kansas

CERTIFICATE

State of Kansas, County of McPherson, ss.

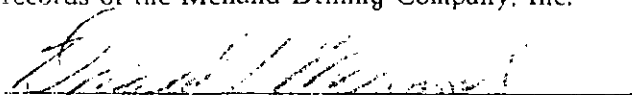I, Donald J. Melland, do hereby certify that the above is a true and correct copy of the log of the above named and described well, as reflected by the records of the Melland Drilling Company, Inc.

Subscribed and sworn to before me, a Notary Public, in and for the County of McPherson, State of Kansas,

this 8th day of March, 1966.My Commission expires: December 23, 1967
Notary Public