


STATE OF KANSAS
STATE CORPORATION COMMISSION

Give All Information Completely
Make Required Affidavit
Mail or Deliver Report to:
Conservation Division
State Corporation Commission
800 Bittling Building
Wichita, Kansas

15169-60136-0000

WELL PLUGGING RECORD

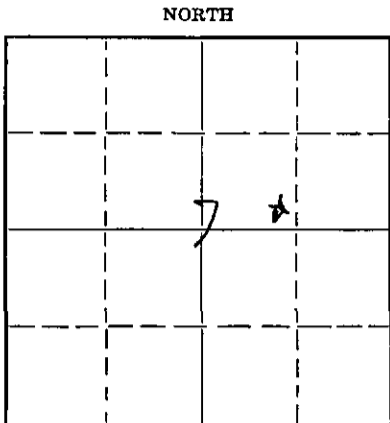

Locate well correctly on above Section Flat

Saline County, Sec. 7 Twp. 16 Rge. 1W (W)
Location as "NE/CNW $\frac{1}{4}$ SW $\frac{1}{4}$ " or footage from lines SE SW NE
Lease Owner Mallard Drilling Company
Lease Name Currie Well No. 1
Office Address 1016 Union Nat'l. Bank - Wichita, Kansas
Character of Well (completed as Oil, Gas or Dry Hole) Dry Hole
Date well completed May 8 1953
Application for plugging filed 19
Application for plugging approved 19
Plugging commenced May 20 1953
Plugging completed May 23 1953
Reason for abandonment of well or producing formation Dry Hole
If a producing well is abandoned, date of last production 19
Was permission obtained from the Conservation Division or its agents before plugging was commenced? Yes

Name of Conservation Agent who supervised plugging of this well Ruell Durkee
Producing formation XXX Depth to top Bottom Total Depth of Well 2670' Feet
Show depth and thickness of all water, oil and gas formations.

OIL, GAS OR WATER RECORDS

CASING RECORD

Formation	Content	From	To	Size	Put In	Pulled Out
				8-5/8"	132'	None
				5-1/2"	2664'	2353'

Describe in detail the manner in which the well was plugged, indicating where the mud fluid was placed and the method or methods used in introducing it into the hole. If cement or other plugs were used, state the character of same and depth placed, from feet to feet for each plug set.

Sanded hole from 2670' to 2655' and ran 5 sacks of cement. Mudded hole from 2625' to 130', set 10' rock bridge to 120' and ran 26 sacks of cement at 120'. Mudded hole to 20', set rock bridge and ran 5 sacks of cement on top. Plugging completed.

(If additional description is necessary, use BACK of this sheet)
Name of Plugging Contractor West Supply Company
Address Chase, Kansas

STATE OF Kansas COUNTY OF Sedgwick, ss.
C. C. Nelson (employee of owner) or (owner or operator) of the above-described well, being first duly sworn on oath, says: That I have knowledge of the facts, statements, and matters herein contained and the log of the above-described well as filed and that the same are true and correct. So help me God.
(Signature) C. C. Nelson - Partner

SUBSCRIBED AND SWORN to before me this 3rd day of June, 1953
Maxwell Wright Notary Public.
My commission expires 12/4/56

23-8390-s 6-51-20M

PLUGGIN
FILE SEC 7 T 16 R 140
BOOK 101 LINE 29

RECEIVED
JUN 4 1953
6-4-53
CONSERVATION DIVISION
Wichita, Kansas

COMPANY: Mallard Drilling Company
 CONTRACTOR: Mallard Drilling Company
 FARM: Currie #1
 LOCATION: SE SW NE Sec. 7-16-1W
 Saline County, Kansas
 COMMENCED: May 1, 1953
 COMPLETED: May 8, 1953

0	to	130	Shale and lime
130	to	160	Lime
160	to	225	Lime
225	to	500	Lime
500	to	650	Lime and sand
650	to	830	Lime and sand
830	to	1000	Shale and lime
1000	to	1810	Shale and lime
1810	to	1880	Shale and sand
1880	to	2040	Shale and lime
2040	to	2160	Lime
2160	to	2365	Lime
2365	to	2641 $\frac{1}{2}$	Shale and lime
2641 $\frac{1}{2}$	to	2664	Shale and lime
2664	to	2669	Mississippi-T. D. Rotary
2669	to	2670	Chat, dolomite and sale water
		2670	T.D. Cardwell

Set 132 feet of 8 5/8" surface pipe. Cemented with 90 sacks cement.

TOPS: K. C. -- 2022 Mississippi Lime -- 2662

Set 5 1/2" pipe at 2664. Cemented with 50 sacks cement.

Elevation -- 1278

DRY, WATER

Measurements taken from R.D.B. 5 1/2' from ground level to R.D.B.

C E R T I F I C A T E

I, C. C. Nelson, do hereby certify that the above and foregoing is a true and correct copy of log of the Currie #1, Saline County, Kansas, as reflected by files of the Mallard Drilling Company.

C. C. Nelson

Subscribed and sworn to before a Notary Public, within and for Sedgwick County, Kansas, this 15th day of May 1953.

Harrell Wright

My commission expires

12/4/56

STATE COMMISSION
 MAY 16 1953
 CONSERVATION DIVISION

PLUGGING
 FILE SEC 7 T 16 R 14
 BOOK PAGE 101 LINE 22