


Give All Information Completely
Make Required Affidavit
Mail or Deliver Report to:
Conservation Division
State Corporation Commission
211 No. Broadway
Wichita, Kansas

WELL PLUGGING RECORD

Twp 16 NORTH Rge 1W

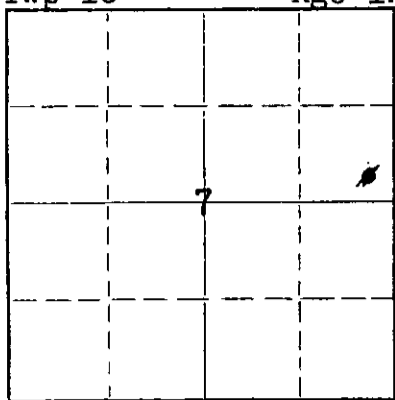

Locate well correctly on above Section Plat

Saline County. Sec. 7 Twp. 16 Rge. (E) 1 (W)
Location as "NE/CNW/SW" or footage from lines SE - SE - NE
Lease Owner Donald T. Ingling et al
Lease Name Currie Well No. 1
Office Address Wichita, Kansas
Character of Well (completed as Oil, Gas or Dry Hole) Oil
Date well completed 3-12 1957
Application for plugging filed 10-6 1958
Application for plugging approved 10-6 1958
Plugging commenced 10-13 1958
Plugging completed 10-15 1958
Reason for abandonment of well or producing formation uneconomical to operate
If a producing well is abandoned, date of last production Oct. 23, 1958
Was permission obtained from the Conservation Division or its agents before plugging was commenced? Yes

Name of Conservation Agent who supervised plugging of this well Gilbert Thoman
Producing formation _____ Depth to top _____ Bottom _____ Total Depth of Well 2698 1/2 Feet
Show depth and thickness of all water, oil and gas formations.

OIL, GAS OR WATER RECORDS

CASING RECORD

FORMATION	CONTENT	FROM	TO	SIZE	PUT IN	PULLED OUT
				8 5/8	118	SNone
				5 1/2	2684	2466.97

Describe in detail the manner in which the well was plugged, indicating where the mud fluid was placed and the method or methods used in introducing it into the hole. If cement or other plugs were used, state the character of same and depth placed, from _____ feet to _____ feet for each plug set.

Sanded to 2675' - dumped 5 sks cement - mudded to 160' - set 10' rock bridge - dumped 30 sks cement - mudded to 40' - set 10' rock bridge - dumped 10 sks cement.

RECEIVED
STATE CORPORATION COMMISSION

FEB 20 1959
2-20-59
CONSERVATION DIVISION
Wichita, Kansas

(If additional description is necessary, use BACK of this sheet)
Name of Plugging Contractor R & D Casing Pulling Company License # 236
Address Box 569 Ellinwood, Kansas

STATE OF Kansas, COUNTY OF Sedgwick, ss.
D. T. Ingling (employee of owner) or (owner or operator) of the above-described well, being first duly sworn on oath, says: That I have knowledge of the facts, statements, and matters herein contained and the log of the above-described well as filed and that the same are true and correct. So help me God.

(Signature) D. T. Ingling
623 1st Nat'l Bank Bldg. Wichita 2
(Address)

SUBSCRIBED AND SWORN TO before me this 31st day of October, 1958

McBlack
Notary Public.

My commission expires Feb. 27, 1960

PLUGGING
FILE SEC 7 T 16 R 1W
BOOK PAGE 133 LINE 42

WELL LOG - CURRIE NO. 1 15-169-00170-0000

Ingling-Waterman et al, Lease Owner

Section 7-16-1W

Donald T. Ingling, Contractor

Location: C SE SE NE

Commenced: 2-28-57
Completed: 3-12-57

County: Saline

Total Depth: 2686' (rotary)

Production:

Elevation: 1320 RB

Casing: 8 5/8" 118' (60 sacks cement)
5 1/2" 2680 1/2" (40 sacks cement)

Figures below indicate bottom formation.

90	shale and shells	2041	shale
118	shale and shells	2050	lime - Lansing
160	lime	2105	lime
250	lime	2175	lime
365	lime	2235	lime
460	lime	2290	lime
550	lime	2340	lime
635	lime	2368	lime
730	lime	2380	shale
820	lime	2425	shale
910	sandy lime - shale streaks	2465	shale
1075	shale - lime streaks - shells	2505	shale and lime
1265	shale and shells	2555	shale and lime
1455	shale and shells	2600	shale and lime
1585	shale	2645	shale and lime
1685	shale and shells	2665	shale
1738	lime	2674	Conglomerate
1815	shale - lime shells	2686	Mississippi
1820	shale and lime	2686	Total Depth
1835	sandy lime		
1945	shale		
1977	shale		
1980	lime - Brown		

I certify this is a true and correct copy of the above mentioned well.

STATE OF KANSAS)
) ss.
SEDGWICK COUNTY)

Subscribed and sworn to before me, a Notary Public, in said county and state.

Notary Public

My commission expires Feb. 27, 1960

PLUGGING
FILE SEC 7 T 16 R 1W
BOOK PAGE 133 LINE 42