


STATE OF KANSAS
STATE CORPORATION COMMISSION

WELL PLUGGING RECORD

Give All Information Completely
Make Required Affidavit
Mail or Deliver Report to
Conservation Division
State Corporation Comm.
245 North Water
Wichita, KS 67202

Barber County, Sec. 1 Twp. 35S Rge. 12W E/W
Location as "NE/CNW $\frac{1}{2}$ SW $\frac{1}{4}$ " or footage from lines
100' E N/2 NW NE
Lease Owner Robinson Oil Co.
Lease Name Wetz A Well No. 1
Office Address 300 West Douglas Wichita, Kansas 67202
Character of Well (Completed as Oil, Gas or Dry Hole)

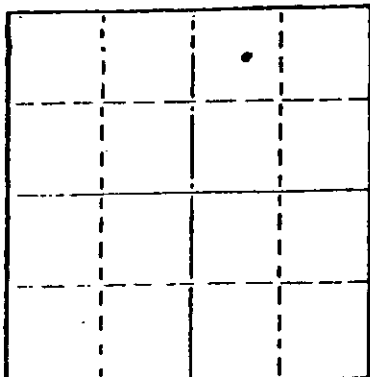

Locate well correctly on above
Section Plat

D & A
Date Well completed 4-26 1979
Application for plugging filed 4-26 1979
Application for plugging approved 4-26 1979
Plugging commenced 4-26 1979
Plugging completed 4-26 1979
Reason for abandonment of well or producing formation

D & A
If a producing well is abandoned, date of last production 19

Was permission obtained from the Conservation Division or its agents before plugging was commenced? Yes

Name of Conservation Agent who supervised plugging of this well Bill Owens
Producing formation Depth to top Bottom Total Depth of Well
Show depth and thickness of all water, oil and gas formations.

OIL, GAS OR WATER RECORDS

CASING RECORD

FORMATION	CONTENT	FROM	TO	SIZE	PUT IN	PULLED OUT
Surface pipe		-0-	753'	8 5/8"	753	None

Describe in detail the manner in which the well was plugged, indicating where the mud fluid was placed and the method or methods used in introducing it into the hold. If cement or other plugs were used, state the character of same and depth placed, from feet to feet for each plug set.

- Filled hole with heavy mud.
- #1 Plug set @ 600' with 50 sacks cement.
- #2 Plug set @ 40' with 12 sacks cement.
- #3 Plug set in rat hole with 3 sacks cement.

(If additional description is necessary, use BACK of this sheet)

Name of Plugging Contractor Sweetman Drilling, Inc.


STATE OF Kansas COUNTY OF Barton, ss.
Gary L. Hawk (employee of owner) or ~~owner~~
of the above-described well, being first duly sworn on oath, says: That I have knowledge of the facts, statements, and matters herein contained and the log of the above-described well as filed and that the same are true and correct. So help me God.

(Signature) Gary L. Hawk
Box 645, Great Bend, Kansas 67530
(Address)

SUBSCRIBED AND SWORN TO before me this 4th day of May, 1979.

Mary Ann Schwamborn
Notary Public.

My commission expires 8-1-81

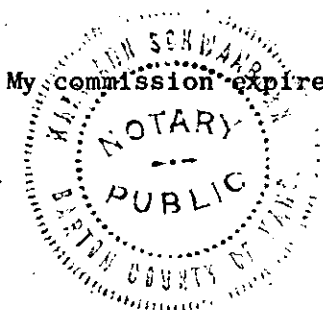

RECEIVED
STATE CORPORATION COMMISSION

MAY - 7 1979
5-7-79
CONSERVATION DIVISION
Wichita, Kansas

WELL LOG
Wetz A#1
100'EN/2 NW NE 1-35S-12W
Barber County, Kansas

Name of Operator: Robinson Oil Co.
300 West Douglas
Wichita, Kansas 67202

Date Completed: April 26, 1979

FROM	TO	
0	963	Red Bed
963	1165	Red bed and shale
1165	4815	Lime and shale
4815	4875	Miss.
4875		Total Depth

STATE OF KANSAS

COUNTY OF BARTON ss

RECEIVED
STATE CORPORATION COMMISSION

MAY - 7 1979
5-7-79
CONSERVATION DIVISION
Wichita, Kansas

Gary L. Hawk, Secretary of Sweetman Drilling, Inc., being first duly sworn on oath says: That I have knowledge of the facts, statements and matters herein contained and the log of the above described well as filed and that the same are true and correct.

Gary L. Hawk
Gary L. Hawk

Subscribed and sworn before me this 3rd day of May, 1979.

Mary Ann Schwamborn
Notary Public Barton County

My Commission Expires 8-1-81

