


STATE OF KANSAS  
STATE CORPORATION COMMISSION

WELL PLUGGING RECORD

Give All Information Completely  
Make Required Affidavit  
Mail or Deliver Report to:  
Conservation Division  
State Corporation Commission  
212 No. Market  
Wichita, Kansas

Barber County, Sec. 6 Twp. 35 Rge. (E) 12 (W)

Location as "NE/CNW%SW%" or footage from lines. C NE SE  
Lease Owner Santa-Fe Pipe & Supply, Inc.  
Lease Name Platt Well No. 1  
Office Address Box 562 - Great Bend, Kansas  
Character of Well (completed as Oil, Gas or Dry Hole) Oil  
Date well completed January 1 19 56  
Application for plugging filed January 13 19 69  
Application for plugging approved January 16 19 69  
Plugging commenced February 10 19 69  
Plugging completed February 18 19 69  
Reason for abandonment of well or producing formation Depleted

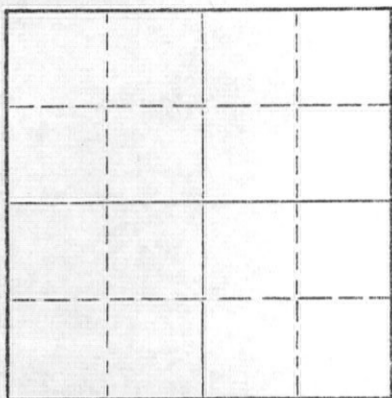

Locate well correctly on above Section Plat

If a producing well is abandoned, date of last production \_\_\_\_\_ 19\_\_\_\_  
Was permission obtained from the Conservation Division or its agents before plugging was commenced? Yes

Name of Conservation Agent who supervised plugging of this well Mr. R. J. Warren  
Producing formation \_\_\_\_\_ Depth to top \_\_\_\_\_ Bottom \_\_\_\_\_ Total Depth of Well 4830 Feet  
Show depth and thickness of all water, oil and gas formations.

OIL, GAS OR WATER RECORDS

CASING RECORD

FORMATION	CONTENT	FROM	TO	SIZE	PUT IN	PULLED OUT
				9 5/8"	253'	None
				5 1/2"	4830'	3834.59'

Describe in detail the manner in which the well was plugged, indicating where the mud fluid was placed and the method or methods used in introducing it into the hole. If cement or other plugs were used, state the character of same and depth placed, from \_\_\_\_\_ feet to \_\_\_\_\_ feet for each plug set.

4830'	-	4740'	-	Sand
4740'	-	4700'	-	5 sacks cement
4700'	-	250'	-	Mud
250'	-	240'	-	Rock Bridge
240'	-	153'	-	35 sacks cement
153'	-	35'	-	Mud
35'	-	25'	-	Rock Bridge
25'	-	Base	-	10 sacks cement

RECEIVED  
STATE CORPORATION COMMISSION  
3-3-69  
MAR 3 1969  
CONSERVATION DIVISION  
Wichita, Kansas

(If additional description is necessary, use BACK of this sheet)  
Name of Plugging Contractor Santa-Fe Pipe & Supply, Inc.  
Address Box 562 - Great Bend, Kansas

STATE OF Kansas, COUNTY OF Barton, ss.  
T. L. Nutt (employee of owner) or ~~(owner or operator)~~ of the above-described well, being first duly sworn on oath, says: That I have knowledge of the facts, statements, and matters herein contained and the log of the above-described well as filed and that the same are true and correct. So help me God.

(Signature) [Signature]

Box 562 - Great Bend, Kansas  
(Address)

SUBSCRIBED AND SWORN TO before me this 27th day of February, 19 69

My commission expires July 31, 1970  
Mary M. Guesnier  
Mary M. Guesnier Notary Public.

15-007-01104-0000

PLATT NO. 1

Center NE SE Section 6-35-12  
Barber County, Kansas  
Aurora Gasoline Company

9-5/8" O. D. casing cemented at 253'  
5-1/2" O. D. casing cemented at 4830'

Drilling commenced December 15, 1955  
Drilling completed January 1, 1956

FROM	TO	FORMATION	REMARKS
0'	253'	Top soil & red bed	9-5/8" O. D. casing cemented with 250 sacks cement at 253'
253	650	Red bed	
650	1380	Shale & shells	
1380	1510	Shale & anhydrite	
1510	1660	Shells & shale	
1660	1730	Shale & lime	
1730	2125	Lime	
2125	2367	Lime & shale	
2367	2814	Shale & lime	
2814	3000	Shale	
3000	3113	Shale & lime	
3113	3235	Lime & shale	
3235	3355	Shale & lime	
3355	3405	Lime & shale	
3405	3515	Shale & lime	
3515	3640	Lime & shale	
3640	3695	Shale & sand	
3695	3715	Sand	
3715	3913	Shale & sand	
3913	3982	Lime & shale	
3982	4060	Shale & lime	
4060	4090	Lime & shale	
4090	4120	Lime	
4120	4165	Shale & lime	
4165	4275	Sand & shale	
4275	4300	Shale & lime	
4300	4415	Shale & sand	
4415	4497	Chalky lime	
4497	4679	Lime	
4679	4695	Chert & lime	
4695	4760	Lime & shale	
4760	4798	Chert, shale & sand	
4798	4830	Lime	5-1/2" O. D. casing cemented with 250 sacks cement at 4830'

RECEIVED  
STATE CORPORATION C  
1-16-69  
JAN 16 1969  
CONSERVATION DIVISION  
Wichita, Kansas

T.D. 4830'

This is a true copy of the driller's log as shown on the drilling tickets.

BARBOUR DRILLING COMPANY

By Bill Priddy

Subscribed and sworn to before me on this 10th day of January, 1956.

Mary Jane Burt  
Notary Public

My commission expires: July 27, 1957