


STATE OF KANSAS
STATE CORPORATION COMMISSION
200 Colorado Derby Bldg.
Wichita, Kansas 67202

Form CP-4
Rev. 12-15-80

WELL PLUGGING RECORD

Give All Information Completely
Make Required Affidavit

COUNTY Comanche SEC. 26 TWP. 33S RGE. 20 XE/W
Location as in quarters or footage from lines:
660' FWL and 660' FSL of SE/4

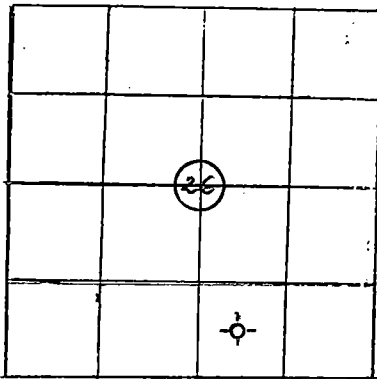

Locate Well
correctly on above
Section Platt.

Lease Owner Halliburton Oil Producing Company
Lease Name Norton Well No. 1
Office Address 2915 Classen Blvd., Okla. City, Okla. 73106
Character of Well (Completed as Oil, Gas or Dry Hole): Dry Hole
Date Well Completed 8-20-82
Application for plugging filed 8-29-82
Plugging commenced 8-20-82
Plugging completed 8-20-82 at 10:00 a.m.
Reason for abandonment of well or producing formation Drilled as a dry hole.

Was permission obtained from the Conservation Division or it's Agent's before plugging was commenced? Yes

Name of Conservation Agent who supervised plugging of this well Paul Luthi
Producing formation None Depth to top bottom T.D. 4830'

Show depth and thickness of all water, oil and gas formations.

OIL, GAS OR WATER RECORDS

Casing Record

Formation	Content	From	To	Size	Put in	Pulled Out

Describe in detail the manner in which the well was plugged, indicating where the mud fluid was placed and the method or methods used in introducing it into the hold. If cement or other plugs were used, state the character of same and depth placed, from feet to feet for each plug set.

<u>690'</u>	<u>-</u>	<u>60 sacks</u>				
<u>300'</u>	<u>-</u>	<u>40 sacks</u>				
<u>40'</u>	<u>-</u>	<u>10 sacks</u>				
<u>Rat hole</u>	<u>-</u>	<u>10 sacks</u>				
<u>Total</u>		<u>120 sacks</u>				

RECEIVED
STATE CORPORATION COMMISSION
SFP 5-1982
CONSERVATION DIVISION
Wichita, Kansas

(If additional description is necessary, use BACK of this sheet)

Name of Plugging Contractor Gabbert-Jones, Inc., 830 Sutton Place, Wichita, Kansas 67202

STATE OF OKLAHOMA COUNTY OF OKLAHOMA, ss.

M. E. Shaw (employee of owner) or (owner or operator) of the above-described well, being first duly sworn on oath, says: That I have knowledge of the facts, statements, and matters herein contained and the log of the above-described well as filed and that the same are true and correct. So help me God.

(Signature) M. E. Shaw
2915 Classen Blvd., OKCA Okla.
(Address) 73106

SUBSCRIBED AND SWORN TO before me this 2nd day of Sept., 1982

Helen C. Flanagan
Notary Public.

My Commission expires: April 24, 1985

GABBERT-JONES, INC.
 WICHITA, KANSAS
 DRILLERS' WELL LOG

Norton #1
 SW SE Sec 26-33S-20W
 Commanche County Kansas

Commenced: 8-9-82

Completed: 8-20-82

OPERATOR: HALLIBURTON OIL PRODUCING CO.

Depth		Formation	Remarks
From	To		
0	99	Sand	
99	676	Sand-Shale	Ran 2 jts of 48# 13 3/8"
676	770	Redbed	csg set @ 99' Cemented
770	2410	Shale	w/100 sks Common
2410	2610	Shale-Lime	2% Gel - 3% CC
2610	2930	Lime-Shale	PD @ 11:00 p.m. 8-9-82
2930	3155	Shale-Lime	Ran 15 jts of 24# 8 5/8"
3155	3715	Lime-Shale	csg set @ 674' Cemented
3715	4830	Lime	w/100 sks Lite 2% Gel
	4830 - TD		3% CC - 50 sks Common
			2% Gel - 3% CC
			Bottom Plug down @ 5:00 p.m.
			8-10-82 Top w/50 sks
			Common 2% Gel - 3% CC
			PD @ 8:00 p.m. 8-10-82

DRY & ABANDONED

STATE OF KANSAS)
) SS
 COUNTY OF SEDGWICK)

I, the undersigned, being duly sworn on oath, state that the above Drillers' Well Log is true and correct to the best of my knowledge and belief and according to the records of this office.

GABBERT-JONES, INC.

James S. Sutton II
 JAMES S. SUTTON II

Subscribed and sworn to before me this 27th day of August, 1982

Elizabeth J. Edwards
 ELIZABETH J. EDWARDS-NOTARY PUBLIC

My Commission expires February 6, 1983.

NOTARY PUBLIC