


STATE OF KANSAS
STATE CORPORATION COMMISSION

15-173-20306-0000
WELL PLUGGING RECORD

Give All Information Completely
Make Required Affidavit
Mail or Deliver Report to
Conservation Division
State Corporation Comm.
245 North Water
Wichita, KS 67202

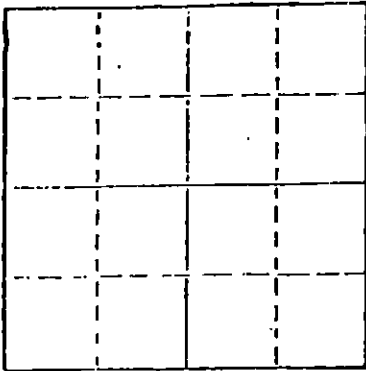

Locate well correctly on above
Section Plat

Sedgwick County. Sec. 33 Twp. 28S Rge. 4 ~~XXW~~
Location as "NE/CNW1SW1" or footage from lines C NW NW NW
Lease Owner Boswell Energy Corporation
Lease Name Smith Well No. 1-33
Office Address 101 Park Ave., Suite 530, Ok. City, Ok.
Character of Well (Completed as Oil, Gas or Dry Hole) dry hole

Date Well completed 11-1 19 80
Application for plugging filed 11-1 19 80
Application for plugging approved 11-1 19 80
Plugging commenced 11-1 19 80
Plugging completed 11-1 19 80
Reason for abandonment of well or producing formation
no commercial quantity of oil or gas encountered
If a producing well is abandoned, date of last production
-- 19

Was permission obtained from the Conservation Division or
its agents before plugging was commenced? yes

Name of Conservation Agent who supervised plugging of this well Don Thompson
Producing formation Depth to top Bottom Total Depth of Well 4410
Show depth and thickness of all water, oil and gas formations.

OIL, GAS OR WATER RECORDS

CASING RECORD

FORMATION	CONTENT	FROM	TO	SIZE	PUT IN	PULLED OUT
surface hole	shale	surf	232	8-5/8	231	none

Describe in detail the manner in which the well was plugged, indicating where the mud fluid
was placed and the method or methods used in introducing it into the hold. If cement or other
plugs were used, state the character of same and depth placed, from feet to
 feet for each plug set.

Fluid to 240', plug, 25 sx
Fluid to 40', plug, 12 sx
Rat hole 3 sx

RECEIVED
STATE CORPORATION COMMISSION
11-05-1980
NOV - 5 1980

CONSERVATION DIVISION
Wichita, Kansas

(If additional description is necessary, use BACK of this sheet)
Name of Plugging Contractor D N B DRILLING, INC.
515 R. H. Garvey Building
Wichita, Kansas 67202

STATE OF Kansas COUNTY OF Sedgwick, ss.
Ella Priess (employee of owner) or (owner or operator)
of the above-described well, being first duly sworn on oath, says: That I have knowledge of
the facts, statements, and matters herein contained and the log of the above-described well
as filed and that the same are true and correct. So help me God.

(Signature)

Ella Priess

515 R.H. Garvey Bldg., Wichita, Ks. 67202
(Address)

SUBSCRIBED AND SWORN TO before me this 4th day of November, 19 80

My commission expires April 30, 1983

Dorothy L. Schmidt
Dorothy L. Schmidt Notary Public.

DOROTHY L. SCHMIDT
STATE NOTARY PUBLIC
Sedgwick County, Kansas
My Appt. Exp. April 30, 1983

DRILLER'S LOG

15-173-20306 0000

BOSWELL ENERGY CORPORATION

Smith No. 1-33

C NW NW NW

Sec 33-28S-4W

Sedgwick Co., Ks.

Commenced: 10-10-80

Completed: 11-1-80

Surface Casing: 231' of 8-5/8"
cemented w/200 sx common

FORMATION

DEPTH

Surface Hole	0 - 232
Lime	232 - 256
Shale & Lime	256 - 2519
Lime & Shale	2519 - 2634
Shale & Lime	2634 - 3280
Lime	3280 - 3643
Lime & Shale	3643 - 3828
Lime	3828 - 4148
Lime & Shale	4148 - 4410 RTD

I do hereby certify that the foregoing statements are true and correct to the best of my knowledge and belief.

D N B DRILLING, INC. STATE CORPORATION COMMISSION

Ella Priess

Ella Priess

RECEIVED
NOV - 5 1980

CONSERVATION DIVISION
Wichita, Kansas

STATE OF KANSAS: ss:

Subscribed and sworn to before me this 4th day of November, 1980.

Dorothy L. Schmidt
Dorothy L. Schmidt, Notary Public

DOROTHY L. SCHMIDT
STATE NOTARY PUBLIC
Sedgwick County, Kansas
My Appt. Exp. April 30, 1983