


15-095-01797-0000

STATE OF KANSAS
STATE CORPORATION COMMISSION

Give All Information Completely
Make Required Affidavit
Mail or Deliver Report to:
Conservation Division
State Corporation Commission
800 Biting Building
Wichita, Kansas

WELL PLUGGING RECORD

NORTH

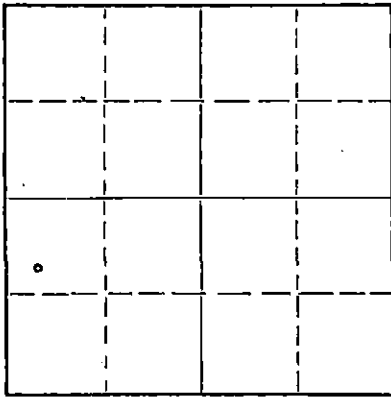

Locate well correctly on above
Section Plat

Kingman County. Sec. 26 Twp. 29S Rge. 7W (E) (W)
Location as "NE/CNW&SW" or footage from lines SW/4 NW/4 SW/4
Lease Owner Drillers Production Co., Inc.
Lease Name Krehbiel Well No. 1
Office Address 212 North Market, Wichita 2, Kansas
Character of Well (completed as Oil, Gas or Dry Hole) Dry hole
Date well completed 6/ 9 1956
Application for plugging filed 6/ 9 1956
Application for plugging approved 6/ 9 1956
Plugging commenced 6/ 9 1956
Plugging completed 6/ 9 1956
Reason for abandonment of well or producing formation Dry hole

If a producing well is abandoned, date of last production 19
Was permission obtained from the Conservation Division or its agents before plugging was commenced? Yes

Name of Conservation Agent who supervised plugging of this well Murell Rives, Pratt, Kansas
Producing formation _____ Depth to top _____ Bottom _____ Total Depth of Well 4190 Feet
Show depth and thickness of all water, oil and gas formations.

OIL, GAS OR WATER RECORDS

CASING RECORD

FORMATION	CONTENT	FROM	TO	SIZE	PUT IN	PULLED OUT
				8 5/8"		
				Surface Pipe	231 feet	

Describe in detail the manner in which the well was plugged, indicating where the mud fluid was placed and the method or methods used in introducing it into the hole. If cement or other plugs were used, state the character of same and depth placed, from _____ feet to _____ feet for each plug set.
Filled hole with mud to 225' set Halliburton Plug - 20 sacks of cement - Filled hole with mud to 35' set Halliburton Plug - 10 sacks of cement.

(If additional description is necessary, use BACK of this sheet)

Name of Plugging Contractor Springer & Harper
Address P. O. Box 187 - Valley Center, Kansas

STATE OF Kansas, COUNTY OF Sedgwick, ss.

(employee of owner) or (owner or operator) of the above-described well, being first duly sworn on oath, says: That I have knowledge of the facts, statements, and matters herein contained and the log of the above-described well as filed and that the same are true and correct. So help me God.

(Signature) L. L. Harper
P. O. Box 187, Valley Center, Kansas
(Address)

SUBSCRIBED AND SWORN TO before me this 14th day of June, 1956

My commission expires August 13, 1959

Notary Public.

PLUGGING
FILE SEC 26 T 29 R 7W
BOOK PAGE 70 LINE 10

RECORDED
STATE CORPORATION COMMISSION
06-16-1956
JUN 16 1956
CONSERVATION DIVISION
Wichita, Kansas

SPRINGER & HARPER

DRILLING CONTRACTORS
VALLEY CENTER, KANSAS

June 9 1956

The Drillers Production Co., Inc.,
Insurance Building
212 North Market Street
Wichita 2, Kansas

Krehbiel No. 1
SW/4 NW/4 SW/4 26 - 29-S,
7-W, Kingman County, Kansas

red shale & shells	0 - 80
shale - shells	400
red shale	485
shale	700
shale - lime	900
salt - shale	1080
salt - anhydrite	1166
salt - shale	1339
shale - lime	1440
lime	1560
lime - shale	1580
lime	1920
lime - shale	1955
lime	2070
lime - shale	2380
lime	2990
lime - shale	3060
lime	3080
lime - shale	3100
shale	3158
shale - lime	3200
sand	3303
lime	3728
black shale	3732
lime	3823
lime - shale	3886
lime	3947
lime - shale	4108
lime	T.D. 4190

Casing
231' (5 JTS.) 8 5/8"
OD Casing, cemented
W/225 sacks of cement.

	<u>Tops</u>	
Heebner shale		3072
Toronto lime		3087
Douglas shale		3116
Lansing lime		3304
Douglas sand		3200
Base/K.C.		3819
Miss.chat		4107
Miss. lime		4117

SPRINGER & HARPER

By L. L. Harper
L. L. Harper

PLUGGING
FILE SEC 26 T 29 R 7W
BOOK PAGE 70 LINE 10

JUN 10 1956
CONSERVATION DIVISION
Wichita, Kansas