


STATE OF KANSAS  
STATE CORPORATION COMMISSION

WELL PLUGGING RECORD

Give All Information Completely  
Make Required Affidavit  
Mail or Deliver Report to  
Conservation Division  
State Corporation Comm.  
245 North Water  
Wichita, KS 67202

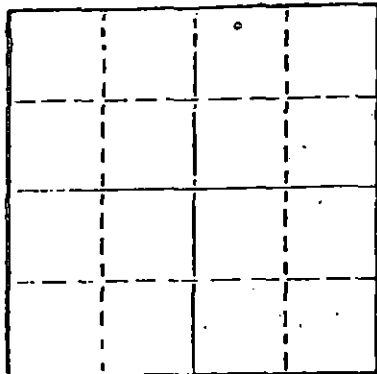

Locate well correctly on above  
Section Plat

Kingman County, Sec. 26 Twp. 29 Rge. 7 E/W  
Location as "NE/CNW $\frac{1}{4}$ /SW $\frac{1}{4}$ " or footage from lines  
N/2 NW NE

Lease Owner Frank J. Black  
Lease Name Graber Well No. 1  
Office Address 600 W. Washington, McPherson, Kansas  
Character of Well (Completed as Oil, Gas or Dry Hole) 67460  
oil

Date Well completed 19  
Application for plugging filed 19  
Application for plugging approved 19  
Plugging commenced July 30 1977  
Plugging completed August 8 1977  
Reason for abandonment of well or producing formation  
depleted

If a producing well is abandoned, date of last production  
19

Was permission obtained from the Conservation Division or  
its agents before plugging was commenced? yes

Name of Conservation Agent who supervised plugging of this well Jasper Metz  
Producing formation Depth to top Bottom Total Depth of Well 4225'  
Show depth and thickness of all water, oil and gas formations.

OIL, GAS OR WATER RECORDS

CASING RECORD

FORMATION	CONTENT	FROM	TO	SIZE	PUT IN	PULLED OUT
			238'	8 5/8"	238'	none
			4224'	5 1/8"	4224'	3610.73

Describe in detail the manner in which the well was plugged, indicating where the mud fluid  
was placed and the method or methods used in introducing it into the hold. If cement or other  
plugs were used, state the character of same and depth placed, from feet to  
feet for each plug set.

Sanded back to 4175' and dumped 5 sacks of cement.

Set 10' rock bridge - top 260'. Plugged well with 4 yards of ready mix cement.

RECEIVED  
STATE CORPORATION COMMISSION

AUG 12 1977

CONSERVATION DIVISION  
Wichita, Kansas

(If additional description is necessary, use BACK of this sheet)

Name of Plugging Contractor PIPE PULLERS, INC.  
Box 128, Ellinwood, Kansas 67526

STATE OF KANSAS COUNTY OF BARTON ss.  
Evelyn Roth

(employee of owner) or (owner or operator) of the above-described  
well, being first duly sworn on oath, says: That I have knowledge of the facts, statements, and matters herein contained and the log of the  
above-described well as filed and that the same are true and correct. So help me God.

(Signature) Evelyn Roth  
Ellinwood, Kansas  
(Address)

Subscribed and Sworn to before me this 10th day of August 1977

My commission expires

JENNY KASSELMAN  
NOTARY PUBLIC  
BARTON COUNTY, KANSAS  
MY COMM. EXP. JULY 16, 1978

Jenny Kasselmann  
Notary Public.

ROTARY DRILLERS' LOG

OPERATOR: Shaffer & Se Ro Bee Drlg. Co.  
404 Wolcott Building  
Hutchinson, Kansas 67501

DRILLING COMMENCED: 7-10-76

CONTRACTOR: Graves Drilling Co., Inc.  
910 Union Center  
Wichita, Kansas 67202

DRILLING COMPLETED: 7-17-76

CASING RECORD: 6 Jts. 238' of used 8-5/8"  
cemented with 225 sacks;  
100 Jts. 4224' of new 5-1/2"  
cemented with 100 sacks

LOCATION: Graber No. 1  
N/2 NW NE  
Section 26-29S-7W  
Kingman County, Ks.

- 0 - 238 Red bed
- 238 - 1380 Shale & sand
- 1380 - 1665 Shale & lime
- 1665 - 1868 Shale
- 1868 - 2200 Shale & shells
- 2200 - 3305 Shale
- 3305 - 3934 Shale & lime
- 3934 - 4225 Lime
- 4225 Rotary Total Depth

RECEIVED  
STATE CORPORATION COMMISSION  
07-11-1977  
JUL 11 1977  
CONSERVATION DIVISION  
Wichita, Kansas

I hereby certify the foregoing statements to be true and correct to the best of my knowledge.

GRAVES DRILLING CO., INC.

By John Graves  
President

STATE OF KANSAS )  
SEDGWICK COUNTY ) SS:

Subscribed and sworn to before me, a Notary Public, this 23rd day of July, 1976

My commission expires: 2 February 1980

Courtney M. Graves  
Courtney M. Graves Notary Public

