

15-095-00442-0000

WELL PLUGGING RECORD


FORMATION PLUGGING RECORD

Strike out upper line when reporting plugging of formations.

STATE OF KANSAS
STATE CORPORATION COMMISSION
Give All Information Completely
Make Required Affidavit
Mail or Deliver Report to:
Conservation Division
State Corporation Commission
800 Bittig Building
Wichita, Kansas

Kingman County, Sec. 28 Twp. 29S Rge. (E) 7 (W)
Location as "NE 1/4 NW 1/4 SW 1/4" or footage from lines NW 1/4 SW 1/4 1980' N & 330 E of SW/c
Lease Owner Stanolind Oil and Gas Company
Lease Name Zella D. Tredick Well No. 1
Office Address Box 591 Tulsa, Oklahoma
Character of Well (completed as Oil, Gas or Dry Hole) Dry Hole
Date well completed March 6, 1942
Application for plugging filed March 6, 1942
Application for plugging approved March 6, 1942
Plugging commenced March 7, 1942
Plugging completed March 7, 1942
Reason for abandonment of well or producing formation Dry Hole
If a producing well is abandoned, date of last production - 19
Was permission obtained from the Conservation Division or its agents before plugging was commenced? Yes

NORTH R-7-W

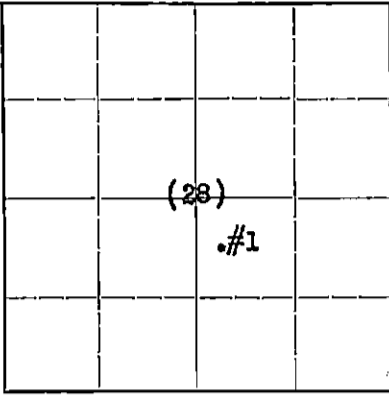

Locate well correctly on above Section Plat

Name of Conservation Agent who supervised plugging of this well Ruel Durkee
Producing formation Arbuckle Depth to top 4637 Bottom 4669 Total Depth of Well 4669 Feet
Show depth and thickness of all water, oil and gas formations.

OIL, GAS OR WATER RECORDS


CASING RECORD

Formation	Content	From	To	Size	Put In	Pulled Out
Lansing Lime	Dry	3350	4122	13"	262	None
Mississippi Lime	Dry	4122	4405			422
Kinderhook	Dry	4405	4518			
Misener	Dry	4518	4519			
Simpson	Dry	4519	4637			
Arbuckle	Dry	4637	4669			

Describe in detail the manner in which the well was plugged, indicating where the mud fluid was placed and the method or methods used in introducing it into the hole. If cement or other plugs were used, state the character of same and depth placed, from feet to feet for each plug set.

Total Depth 4669' - Plugged with heavy mud 4669 to 260; 15 sacks of cement 260 to 222; heavy mud 222 to 21; 5 sacks of cement 21 to 6; 10 sacks of cement in bottom of cellar after cap was welded on 13" casing at 6'; mud and dirt to ground level.

FILE 28 29 2W
BOOK 28 29 2W

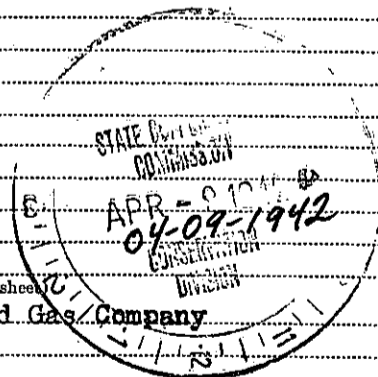

Correspondence regarding this well should be addressed to Stanolind Oil and Gas Company
Address Box 591 Tulsa, Oklahoma

STATE OF Kansas, COUNTY OF Stafford, ss.
C. B. Snyder (employee of owner) or (owner or operator) of the above-described well, being first duly sworn on oath, says: That I have knowledge of the facts, statements, and matters herein contained and the log of the above-described well as filed and that the same are true and correct. So help me God.


(Signature) C. B. Snyder Ass't Field Sup't
Box 487 Stafford, Kansas (Address)

SUBSCRIBED AND SWORN to before me this 7th day of April, 1942
George A. Banks Notary Public.
My commission expires Feb. 6, 1946

STANOLIND OIL AND GAS COMPANY

WELL RECORD

640 Acres
N R-7W

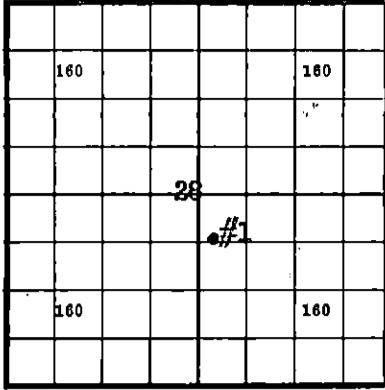

Locate Well Correctly

COUNTY Kingman, SEC. 28, TWP. 29S, RGE. 7W
 COMPANY OPERATING Stanolind Oil and Gas Company
 OFFICE ADDRESS Box 591 Tulsa, Oklahoma
 FARM NAME Zella D. Tredick WELL NO. 1
 DRILLING STARTED 2-5-1942, DRILLING FINISHED 3-6-1942
 WELL LOCATED 1/4 NW 1/4 SW 1/4 1980 ft. North of South
 Line and 330 ft. East of West Line of Quarter Section.
 ELEVATION (Relative to sea level) DERRICK FLR. 1532 GROUND 1529
 CHARACTER OF WELL (Oil, gas or dry hole) Dry Hole

T
29
S

OIL OR GAS SANDS OR ZONES

Name	From	To	Name	From	To
1 Lansing Lime	3350	4122	4 Misener	4518	4519
2 Mississippi Lime	4122	4405	5 Simpson	4519	4637
3 Kinderhook Shale	4405	4518	6 Arbuckle	4637	4669

WATER SANDS

Name	From	To	Water Level	Name	From	To	Water Level
1				4			
2				5			
3				6			

CASING RECORD

Size	Wt.	Thds.	Make	Amount Set		Amount Pulled		Packer Record			
				Ft.	In.	Ft.	In.	Size	Length	Depth Set	Make
13"	50#	8 rt	LW	261'	4"	(this off)			landed	265'	10"

Liner Record: Amount _____ Kind _____ Top _____ Bottom _____


CEMENTING AND MUDDING RECORD

Size O. D.	Amount Set		Sacks Cement	Chemical		Method Cementing	Amount	Mudding Method	Results (See Note)
	Feet	In.		Gal.	Make				
13"	262'	0"	200		Dewey	Howco			

PIPING
FILE SEC. 28 - 29S - 7W
BOOK PAGE 28 LINE 4

NOTE: What method was used to protect sands when outer strings were pulled?

NOTE: Were bottom hole plugs used? _____ If so, state kind, depth set and results obtained

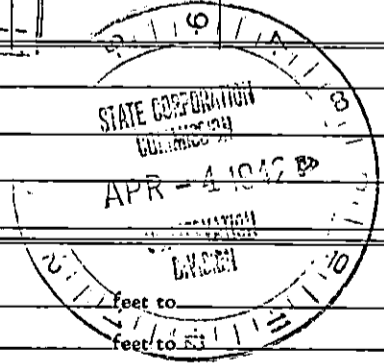

TOOLS USED

Rotary tools were used from 0 feet to 4669 feet, and from _____ feet to _____ feet
 Cable tools were used from _____ feet to _____ feet, and from _____ feet to _____ feet
 Type Rig 94' steel

PRODUCTION DATA


None
 Production first 24 hours _____ bbls. Gravity _____, Emulsion _____ per cent., Water _____ per cent
 Production second 24 hours _____ bbls. Gravity _____, Emulsion _____ per cent., Water _____ per cent

If gas well, cubic feet per 24 hours _____ Rock Pressure, lbs. per square inch _____

I, the undersigned, being first duly sworn upon oath, state that this well record is true, correct and complete according to the records of this office and to the best of my knowledge and belief.

W. Snyder Ass't Field Sup't
Name and Title

Subscribed and sworn to before me this the 1st day of April, 1942
 My commission expires Feb. 6, 1946
George A. Banks Notary Public.

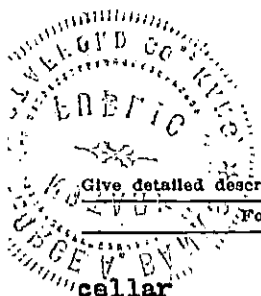

FORMATION RECORD

Give detailed description and thickness of all formations drilled through and contents of sand, whether dry, water, oil or gas.

Formation	Top	Bottom	Formation	Top	Bottom?
cellar	0	8'6"			
red bed	8'6"	340'			
shale	340	975			
shale and salt	975	1100			
lime	1100	1405			
shale and lime	1405	1490			
broken lime	1490	1790			
shale	1790	2420			
broken lime	2420	2515			
shale	2515	2600			
broken lime and shale	2600	2700			
shale	2700	2725			
broken lime	2725	2805			
shale	2805	2941			
lime	2941	3000			
shale and lime	3000	3105			
broken lime	3105	3200			
shale	3200	3255			
sand	3255	3350			
lime	3350	3803			
lime broken	3803	3905			
lime and shale	3905	3957			
broken lime	3957	4000			
shale	4000	4122			
lime	4122	4400			
shale	4400	4531			
hard sand	4531	4596			
broken sand and shale	4596	4618			
shale	4618	4669			
<u>Total Depth</u>	4669				