


15-095-00343-0000

STATE OF KANSAS
STATE CORPORATION COMMISSION

Give All Information Completely
Make Required Affidavit
Mail or Deliver Report to:
Conservation Division
State Corporation Commission
211 No. Broadway
Wichita, Kansas

WELL PLUGGING RECORD

NORTH

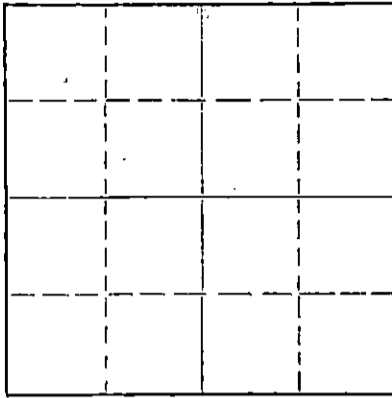

Locate well correctly on above
Section Plat

Kingman County. Sec. 29 Twp. 29 Rge. 7 (B) (W)

Location as "NE/CNW/SW" or footage from lines 67 SW 52
Lease Owner Rupp-Ferguson Oil Co.
Lease Name Birkenbaugh Well No. 1
Office Address 522 Union Center, Wichita, Kansas
Character of Well (completed as Oil, Gas or Dry Hole) Dry Hole
Date well completed 5-31-59 19
Application for plugging filed 5-31-59 19
Application for plugging approved 5-31-59 19
Plugging commenced 5-31-59 19
Plugging completed 5-31-59 19
Reason for abandonment of well or producing formation _____

If a producing well is abandoned, date of last production _____ 19
Was permission obtained from the Conservation Division or its agents before plugging was commenced? Yes

Name of Conservation Agent who supervised plugging of this well Fred W. Hampel
Producing formation _____ Depth to top _____ Bottom _____ Total Depth of Well 4254 Feet
Show depth and thickness of all water, oil and gas formations.

OIL, GAS OR WATER RECORDS

CASING RECORD

FORMATION	CONTENT	FROM	TO	SIZE	PUT IN	PULLED OUT
				8 5/8"	250'	0

Describe in detail the manner in which the well was plugged, indicating where the mud fluid was placed and the method or methods used in introducing it into the hole. If cement or other plugs were used, state the character of same and depth placed, from _____ feet to _____ feet for each plug set.

Plugged hole at 340' with 20 sacks cement through drill pipe; and to 35'. Plugged with 10 sacks mulls to base of collar. Torn down.

RECEIVED
STATE CORPORATION COMMISSION
06-03-1959
JUN 3 1959

CONSERVATION DIVISION
Wichita, Kansas

(If additional description is necessary, use BACK of this sheet)
Name of Plugging Contractor Rupp-Ferguson Oil Co.
Address 522 Union Center, Wichita, Kansas

STATE OF Kansas COUNTY OF Sedgwick SS. _____
J. F. Carter, Jr. (employee of owner) or (owner or operator) of the above-described well, being first duly sworn on oath, says: That I have knowledge of the facts, statements, and matters herein contained and the log of the above-described well as filed and that the same are true and correct. So help me God.

(Signature) J. F. Carter, Jr.
522 Union Center, Wichita, Kansas
(Address)

SUBSCRIBED AND SWORN TO before me this 1st day of June, 1959

My commission expires May 11, 1963

Marguerite Dickey Marquitta Dickey
Notary Public.

PLUGGING
FILE SEC 29 T. 29 R 74
BOOK PAGE 42 L 3

CONTRACTOR'S WELL LOG

Rupp-Ferguson No. 1 Birkenbaugh
SW SW SE Section 29-298-7W
Kingman County, Kansas

Elevation 1504 D.F.
Set 8 5/8" @ 250' w/ 150 sacks

Contractor: Rupp-Ferguson Oil Co.
Commenced: 5-20-59
Completed: 5-31-59

Figures Indicate Bottom of Formation

- 251 red rock
- 870 shale
- 928 salt and shale
- 940 anhydrite
- 1253 shale, shells and lime
- 1465 shale and lime
- 1654 lime
- 1800 lime and shale
- 2253 shale
- 2513 shale with lime streaks
- 2890 shale
- 3208 lime and shale
- 3397 sand, lime and shale
- 3542 lime
- 3631 lime and shale
- 3943 lime
- 4060 lime and shale
- 4140 shale with lime streaks
- 4254 Mississippian T.D.

RECEIVED
 STATE COMMISSION
 JUN 3 1959
 CONSERVATION DIVISION
 Wichita, Kansas

STATE OF KANSAS)
) SS:
 COUNTY OF SEDGWICK)

I, J. F. Carter, Jr., Petroleum Engineer for Rupp-Ferguson Oil Co., do hereby certify the above and foregoing to be a true and correct copy of the log of the No. 1 Birkenbaugh well.

J. F. Carter, Jr.
 J. F. Carter, Jr.

Subscribed and sworn to before me this 1st day of June, 1959.

Marguerite Klickey
 Notary Public

My Commission Expires May 11, 1963

PLUGGING
 FILE SEC. 22 T. 29 R. 7W
 BOOK PAGE 42 LINE 9