

15-095-00014-0000


STATE OF KANSAS
STATE CORPORATION COMMISSION

WELL PLUGGING RECORD

Give All Information Completely
Make Required Affidavit
Mail or Deliver Report to:
Conservation Division
State Corporation Commission
800 Bitting Building
Wichita, Kansas

Kingman County. Sec. 36 Twp. 29S Rge. 8 (W)
Location as "NE/CNW/SW" or footage from lines NW SE SW
Lease Owner Gulf Oil Corporation
Lease Name Eli Albright Well No. 1
Office Address Box 661, Tulsa, Oklahoma
Character of Well (completed as Oil, Gas or Dry Hole) Dry hole
Date well completed 11-8 19 56
Application for plugging filed 11-9 19 56
Application for plugging approved 11-9 19 56
Plugging commenced 11-9 19 56
Plugging completed 11-9 19 56
Reason for abandonment of well or producing formation Dry hole

NORTH

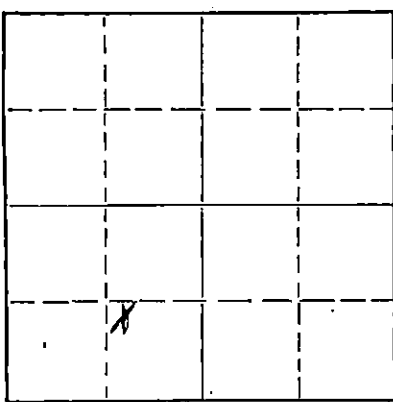

Locate well correctly on above
Section Plat

If a producing well is abandoned, date of last production 19
Was permission obtained from the Conservation Division or its agents before plugging was commenced? Yes

Name of Conservation Agent who supervised plugging of this well M. A. Rives
Producing formation Dry hole Depth to top Bottom Total Depth of Well 4215 Feet
Show depth and thickness of all water, oil and gas formations.

OIL, GAS OR WATER RECORDS

CASING RECORD

FORMATION	CONTENT	FROM	TO	SIZE	PUT IN	PULLED OUT
				8-5/8"	201	- 0 -

Describe in detail the manner in which the well was plugged, indicating where the mud fluid was placed and the method or methods used in introducing it into the hole. If cement or other plugs were used, state the character of same and depth placed, from feet to feet for each plug set.

Filled with mud to 200'. Spotted 20 sacks regular cement thru drill pipe on HOWCO plug at 200'. Filled with mud to 35'. Dumped 1/4 sack cottonseed hulls on HOWCO plug at 35' and filled into cellar with cement.

NOTE: Attached is formation log which was not filed with Application. It is being sent at this time in compliance with your instructions.

Name of Plugging Contractor (If additional description is necessary, use BACK of this sheet)
Name of Plugging Contractor Lewis Drilling Company
Address 915 Union Center Building, Wichita, Kansas

STATE OF Kansas, COUNTY OF Sedgwick, ss.
T. A. Trax (employee of owner) or (CONTRACTOR) of the above-described well, being first duly sworn on oath, says: That I have knowledge of the facts, statements, and matters herein contained and the log of the above-described well as filed and that the same are true and correct. So help me God.

(Signature) [Signature]
Box 2233, Wichita 1, Kansas
(Address)

SUBSCRIBED AND SWORN to before me this 19th day of November, 19 56

My commission expires 2-1-59 Notary Public.

JRM:BJT
Attachment - 1

RECEIVED
STATE CORPORATION COMMISSION
11-21-1956
NOV 21 1956
PLUGGING
FILE SEC 36 T. 29 R. 8W
BOOK PAGE 114 LINE 45 CONSERVATION DIVISION
Wichita, Kansas

WELL LOG

COMPANY **Gulf Oil Corporation**
FARM **Eli Albright** NO. **1**

SEC. **36** T. **29** R. **8**
NW/4 SE/4 SW/4

Kingman

COUNTY **KANSAS**



TOTAL DEPTH **1215'**
DDMM. **10-23-56**

COMP. **11-9-56**

SHOT OR TREATED
CONTRACTOR
ISSUED

ELEVATION **1564 K.B.**

PRODUCTION

CASING

20	10	
15	8 5/8"	216'
12	6	
13	5	

FIGURES INDICATE BOTTOM OF FORMATIONS

- 0 - 216 Surface Soil & Shale
- 216 - 700 Shale & Shells & Red Beds
- 700 - 1200 Shale
- 1200 - 1310 Shale & Shells
- 1310 - 1435 Anhydrite & Lims
- 1435 - 3435 Shale & Lims
- 3435 - 3880 Lims
- 3880 - 4165 Lims & Shale
- 4165 - 4215 Chert & Lims
- 4215 - T.D.

GEOLOGIC TOPS:

- Hebner Shale 3187'
- Douglas Group 3224'
- Lansing K.C. 3425'
- Miss. Chert 4167'
- Miss. Lims 4186'
- Total Depth 4215'

PLUGGING

FILE SEC **36 T. 29 R. 8 W.**
BOOK PAGE **114** LINE **45**

State of KANSAS
County of SEDGWICK) ss:

I, William J. Duckett of the Louis Drilling Company

upon oath state that the above and foregoing is a true and correct copy of the log of the Eli Albright #1 well.

STATE COMMISSION

NOV 21 1956

William J. Duckett
(William J. Duckett)

Subscribed and sworn to before me this 16th day of November, 1956

My Commission Expires August 20, 1950

A. R. Derrington
(A. R. Derrington) PUBLIC