


STATE OF KANSAS  
STATE CORPORATION COMMISSION

Give All Information Completely  
Make Required Affidavit  
Mail or Deliver Report to:  
Conservation Division  
State Corporation Commission  
212 North Market, Insurance Bldg.  
Wichita, Kansas

RE  
WELL-PLUGGING RECORD

NORTH

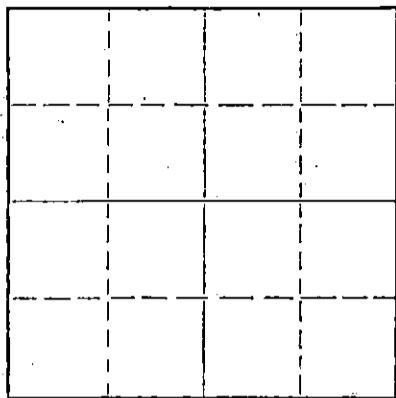

Locate well correctly on above  
Section Plat

Kingman County, Sec. 15 Twp. 29 Rge. 7W (E) (W)  
Location as "NE/CNW/SW" or footage from lines. SE SE NW  
Lease Owner Pickrell Drilling Co.  
Lease Name Birkenbaugh Well No. "A" # 1  
Office Address 2820 Paseo, Great Bend, Kansas  
Character of Well (completed as Oil, Gas or Dry Hole)  
Date well completed 19\_\_\_\_  
Application for plugging filed yes 19\_\_\_\_  
Application for plugging approved yes 19\_\_\_\_  
Plugging commenced 8-22-60 19\_\_\_\_  
Plugging completed 8-26-60 19\_\_\_\_  
Reason for abandonment of well or producing formation \_\_\_\_\_

If a producing well is abandoned, date of last production 19\_\_\_\_  
Was permission obtained from the Conservation Division or its agents before plugging was commenced? yes

Name of Conservation Agent who supervised plugging of this well Fred Hampel  
Producing formation \_\_\_\_\_ Depth to top \_\_\_\_\_ Bottom \_\_\_\_\_ Total Depth of Well 4509' Feet  
Show depth and thickness of all water, oil and gas formations. (PB) 4000'

OIL, GAS OR WATER RECORDS

CASING RECORD

FORMATION	CONTENT	FROM	TO	SIZE	PUT IN	PULLED OUT
				5 1/2"		3,271'

Describe in detail the manner in which the well was plugged, indicating where the mud fluid was placed and the method or methods used in introducing it into the hole. If cement or other plugs were used, state the character of same and depth placed, from \_\_\_\_\_ feet to \_\_\_\_\_ feet for each plug set.

Plugging commenced 8-22-60. Plugging completed 8-26-60.  
Measured in to find total depth, 4,000'. Plugged off bottom:  
Sanded back from total depth to 3500' and dumped 4 sacks of cement.  
Worked and shot casing. Worked and shot 5 1/2" casing free at 3271'.  
Built rack and slide. Pulled and laid down casing. Plugged well:  
Mudded hole up to 230'. Set 10' rock bridge at 230'. Dumped 20  
sacks of cement on rock. Mudded hole up to 40'. Set 10' rock  
bridge at 40'. Capped the well with 10 sacks of cement.

RECEIVED  
STATE CORPORATION COMMISSION  
9-9-60  
SEP 9 1960

(If additional description is necessary, use BACK of this sheet)  
Name of Plugging Contractor J. O. Forbes d/b/a Forbes Casing Pulling Co. Conservation Division  
Address Box 221 Great Bend, Kansas Wichita, Kansas

STATE OF Kansas, COUNTY OF Barton, ss.  
J. O. Forbes (employee of owner) or (owner or operator) of the above-described well, being first duly sworn on oath, says: That I have knowledge of the facts, statements, and matters herein contained and the log of the above-described well as filed and that the same are true and correct. So help me God.

(Signature) J. O. Forbes  
Box 221 Great Bend, Kansas  
(Address)

SUBSCRIBED AND SWORN to before me this 29th day of August, 19 60

My commission expires December 8th, 1963 Kayann Jenkins Notary Public.



ROTARY DRILLING LOG

COMPANY: Pickrell Drilling Company  
Wichita, Kansas

Rotary Drilling Commenced 6/7/57

Rotary Drilling Completed 6/23/57

LOCATION: SE SE NW Sec. 15-29S-7W, Kingman County, Kansas

Birkenbaugh #1

CONTRACTOR: **PICKRELL DRILLING COMPANY**  
Wichita, Kansas

CASING RECORD: 240' (6 jts.) 8 5/8" Armeo Spiralweld Casing cemented with 175 sacks cement circulated

140 jts. 5 1/2" 11# J-55 Seamless Casing set at 4502' cemented with 200 sacks cement.

LOG

(Figures indicate bottom of formation — measurements from top of rotary bushing.)

Sand	110	Circ. for samples at	3751
Red Bed	120		3765
Red Rock	280		3807
Shale	820		4100
Salt, Shale & Shells	1105		4130
Lime & Shale	1270		4140
Lime	1350		4495
Lime & Shale	1710		4500
Lime	1905		4508
Lime & Shale	2535		
Shale, Lime & Sand	2765		
Lime	3007		
Lime, Shale, & Sand	3271		
Lime & Shale	3395		
Lime	3844		
Lime & Shale	3905		
Lime	3950		
Lime & Shale	4700		
Lime	4710		
Mississippi Lime	4750		
Mississippi	4790		
Lime	4245		
Lime & Shale	4354		
Lime	4385		
Shale & Lime	4458		
Lime	4503		
Viola Lime	4508 T.D.		

**RECEIVED**  
STATE CORPORATION COMMISSION

OCT 7 1960  
10-7-60  
CONSERVATION DIVISION  
Wichita, Kansas

S.I.M. at 2000 - O.K.  
3000 - "  
4000 - "  
Slope Test at 2000 - 0° off  
3000 - 0° off  
4000 - 0° off

The undersigned, G. W. Sabin, Attorney-in-Fact for PICKRELL DRILLING COMPANY, hereby certifies in behalf of said Company, that the above is a true and correct log of the formation encountered in drilling the above well as reflected by the Daily Drilling Reports.

**PICKRELL DRILLING COMPANY**  
By G. W. Sabin  
Attorney-in-Fact

STATE OF KANSAS  
COUNTY OF SEDGWICK

On this 23rd day of June, 1957, before me the undersigned, a Notary Public, in and for the County and State aforesaid, personally appeared G. W. Sabin, to me known to be the identical person who subscribed the name of PICKRELL DRILLING COMPANY to the foregoing instrument as its Attorney-in-Fact and acknowledged to me that he executed the same as his free and voluntary act and deed, and as the free and voluntary act and deed of such company, for the uses and purposes therein set forth.

Given under my hand and seal of office the day and year last above written.

My commission expires 2503  
Wesley D. Sabin  
Notary Public