


STATE OF KANSAS
STATE CORPORATION COMMISSION

WELL PLUGGING RECORD

Give All Information Completely
Make Required Affidavit
Mail or Deliver Report to:
Conservation Division
State Corporation Commission
800 Biting Building
Wichita, Kansas

KINGMAN County, Sec. 17 Twp. 29 Rge. 7 ~~W~~ W (W)

Location as "NE/CNW/SE" or footage from lines SW SW SE
Lease Owner PETROLEUM, INC.
Lease Name CASTLE Well No. 1
Office Address ROUTE 2, GREAT BEND, KANSAS
Character of Well (completed as Oil, Gas or Dry Hole) Dry Hole
Date well completed October 19 19 56
Application for plugging filed October 20 19 56
Application for plugging approved October 19 19 56
Plugging commenced October 19 19 56
Plugging completed October 19 19 56
Reason for abandonment of well or producing formation No Producing Zones

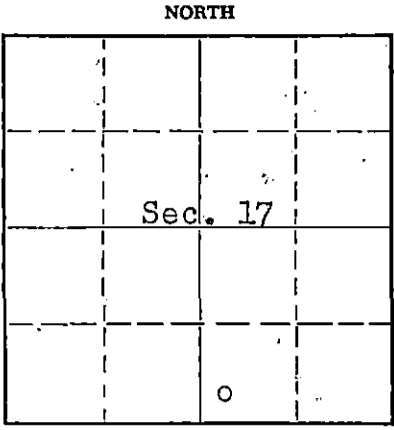

Locate well correctly on above
Section Plat

If a producing well is abandoned, date of last production None 19
Was permission obtained from the Conservation Division or its agents before plugging was commenced? Yes

Name of Conservation Agent who supervised plugging of this well M.A. Rives Pratt, Kansas
Producing formation ----- Depth to top --- Bottom --- Total Depth of Well 4544' Feet
Show depth and thickness of all water, oil and gas formations.

OIL, GAS OR WATER RECORDS

CASING RECORD

FORMATION	CONTENT	FROM	TO	SIZE	PUT IN	PULLED OUT
				8 5/8" OD	203.57'	None

Describe in detail the manner in which the well was plugged, indicating where the mud fluid was placed and the method or methods used in introducing it into the hole. If cement or other plugs were used, state the character of same and depth placed, from _____ feet to _____ feet for each plug set.

Mud up with heavy mud to 200' pushed down 1/4 sack hulls to 200' followed by wooden plug. Placed 20 sacks cement through drill pipe on to plug. Mud up to 35' and placed 1/4 sack hulls at 35' followed by wooden plug and 10 sacks cement to base of well cellar.

(If additional description is necessary, use BACK of this sheet)

Name of Plugging Contractor GARVEY DRILLING CO.
Address ROUTE 2, GREAT BEND, KANSAS

STATE OF KANSAS, COUNTY OF BARTON, ss.
DON SEARLE (employee of owner) or ~~owner~~ operator of the above-described well, being first duly sworn on oath, says: That I have knowledge of the facts, statements, and matters herein contained and the log of the above-described well as filed and that the same are true and correct. So help me God.

(Signature) Don Searle

ROUTE 2, GREAT BEND, KANSAS (Address)

SUBSCRIBED AND SWORN to before me this 24th day of October, 19 56

Zed J. Brown, Notary Public.

My commission expires July 11, 1960

PLUGGING
FILE SEC. 17 T. 29 R. 7W
BOOK PAGE 109 LINE 18

RECEIVED
OCT 25 1956
10-25-56
CONSERVATION DIVISION
Wichita, Kansas

15-095-00012-0000
WELL LOG

COMPANY PETROLEUM, INCORPORATED

SEC. 17 T. 29S R. 7W

FARM Cas tle

NO. 1

LOC. SW,SW,SE


TOTAL DEPTH 4544'

COUNTY Kingman, Co., Kansas

COMM. October 1, 1956

COMP. October 19, 1956

CONTRACTOR GARVEY DRILLING COMPANY

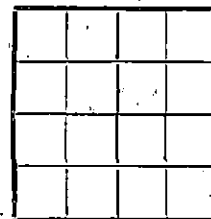

CASING 8 5/8" @ 203.57' W/125 sax.

ELEVATION 1600' DF

PRODUCTION D & A

FIGURES INDICATE BOTTOM OF FORMATIONS

40	Clay & sand	Lansing	3386'
205	Shale & red rock	Base K. C.	3870'
703	Red bed & shale		
995	Shale & shells		
1015	Salt		
1150	Shale & shells		
1505	Lime & shale		
1910	Lime		
2465	Shale & lime		
2550	Lime		
2766	Lime & shale		
2867	Lime		
3438	Lime & shale		
3929	Lime		
3980	Lime & shale		
4012	Lime		
4155	Shale & lime		
4166	Mississippi Chert		
4200	Chert & lime		
4247	Lime & shale		
4282	Lime		
4356	Lime & shale		
4390	Lime		
4539	Lime & shale		
4544	Lime		
4544	T. D.		

State of KANSAS

County of BARTON

PLUGGING
FILE SEC 17 T. 29 R. 7W
BOOK PAGE 109 LINE 18

RECEIVED
CONSERVATION COMMISSION

OCT 25 1956 10-25-56

CONSERVATION DIVISION
Wichita, Kansas

I, Verne A. Morris of Garvey Drilling Co.

upon oath state that the above and foregoing is a true and correct copy of the log of the #1 Castle well

Verne A. Morris

Subscribed and sworn to before me this 23rd day of October 19 56

My Commission Expires: July 11, 1960

Led J. Brown
NOTARY PUBLIC