

RECEIVED  
STATE CORPORATION COMMISSION

MAY 10 1972

5-10-72


STATE OF KANSAS  
STATE CORPORATION COMMISSION

CONSERVATION DIVISION  
Wichita, Kansas

WELL PLUGGING RECORD

Give All Information Completely  
Make Required Affidavit  
Mail or Deliver Report to:  
Conservation Division  
State Corporation Commission  
212 No. Market  
Wichita, Kansas 67202

Kingman County, Sec. 17 Twp. 29 Rge. 7 (E) W (W)  
Location as "NE/CNW%SW%" or footage from lines C NE SE  
Lease Owner McCoy Petroleum Company  
Lease Name Castle Well No. 1  
Office Address 502 Union Center Wichita, Kansas 67202  
Character of Well (completed as Oil, Gas or Dry Hole) Oil Well  
Date well completed April 5, 19 68  
Application for plugging filed April 14, 19 72  
Application for plugging approved 19  
Plugging commenced April 17, 19 72  
Plugging completed April 20, 19 72  
Reason for abandonment of well or producing formation Depleted

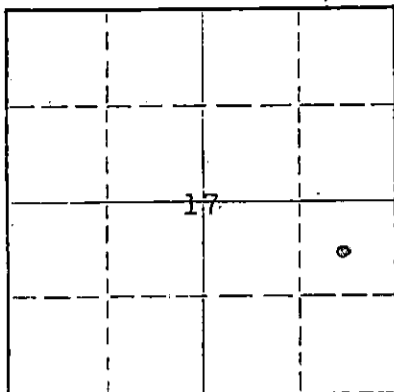

Locate well correctly on above  
Section Plat

If a producing well is abandoned, date of last production April 13, 19 72  
Was permission obtained from the Conservation Division or its agents before plugging was commenced? Yes

Name of Conservation Agent who supervised plugging of this well RUSSELL BIBERSTEIN  
Producing formation Mississippian Depth to top 4143 Bottom 4250 Total Depth of Well 4250 Feet  
Show depth and thickness of all water, oil and gas formations.

OIL, GAS OR WATER RECORDS

CASING RECORD

FORMATION	CONTENT	FROM	TO	SIZE	PUT IN	PULLED OUT
Mississippian	Oil	4143	4202	8-5/8"	220'	None
				5-1/2"	4249'	3136-10'

Describe in detail the manner in which the well was plugged, indicating where the mud fluid was placed and the method or methods used in introducing it into the hole. If cement or other plugs were used, state the character of same and depth placed, from \_\_\_\_\_ feet to \_\_\_\_\_ feet for each plug set.

- 4250' - 4218' - PLUG
- 4218' - 4120' - SAND
- 4120' - 4080' - 5 SACKS CEMENT
- 4080' - 190' - MUD
- 190' - 180' - ROCK BRIDGE
- 180' - BASE - DUMPED 3 YARDS OF READY MIX

(If additional description is necessary, use BACK of this sheet)  
Name of Plugging Contractor SANTA-FE PIPE & SUPPLY, INC.  
Address BOX 562 - GREAT BEND, KANSAS 67530

STATE OF KANSAS, COUNTY OF BARTON, ss.  
I. L. NUTT (employee of owner) or (owner or operator) of the above-described

well, being first duly sworn on oath, says: That I have knowledge of the facts, statements, and matters herein contained and the log of the above-described well as filed and that the same are true and correct. So help me God.

(Signature) [Signature]  
BOX 562 - GREAT BEND, KANSAS 67530  
(Address)

SUBSCRIBED AND SWORN to before me this 9th day of May, 19 72

My commission expires July 31, 1974

Mary M. Guesnier  
Mary M. Guesnier Notary Public.

GABBERT-JONES, INC.  
 WICHITA, KANSAS  
 DRILLERS' WELL LOG

CASTLE #1  
 C NE SE SECTION 17-29S-7W  
 KINGMAN COUNTY, KANSAS

COMMENCED: MARCH 25, 1968  
 COMPLETED: APRIL 5, 1968

OPERATOR - BARBARA OIL COMPANY

RECEIVED  
 STATE CORPORATION COMMISSION  
 APR 17 1972  
 CONSERVATION DIVISION  
 Wichita, Kansas

DEPTH	FORMATION	REMARKS
FROM	TO	
0	40	SHALE AND SAND
40	220	REG. BED RAN 6 JOINTS 8-5/8" CASING, SET @ 220' w/200 BAGS CEMENT.
220	1160	SHALE AND SHELLS
1160	1174	ANHYDRITE
1174	1250	SHALE AND SHELLS
1250	1470	SHALE AND LIME
1470	1816	LIME
1816	3025	LIME AND SHALE
3025	4250	LIME
4250	TD	RAN 132 JOINTS 5 1/2" CASING, SET @ 4249' w/175 BAGS CEMENT.

I, E. E. HALL, CERTIFY THIS IS A CORRECT COPY OF THE DRILLERS' LOG FOR THE WELL DRILLED IN THE C NE SE SECTION 17-29S-7W, KINGMAN COUNTY, KANSAS, TO THE BEST OF MY KNOWLEDGE AND BELIEF.

*E. E. Hall*  
 \_\_\_\_\_  
 E. E. HALL

STATE OF KANSAS )  
 ) SS  
 COUNTY OF SEDGWICK )

BEFORE ME, THE UNDERSIGNED, A NOTARY PUBLIC WITHIN AND FOR SAID COUNTY AND STATE, ON THIS 8TH DAY OF APRIL, 1968, PERSONALLY APPEARED E. E. HALL, TO ME PERSONALLY KNOWN TO BE THE IDENTICAL PERSON WHO EXECUTED THE WITHIN AND FOREGOING INSTRUMENT AND ACKNOWLEDGED TO ME THAT HE EXECUTED THE SAME AS HIS FREE AND VOLUNTARY ACT AND DEED FOR THE USES AND PURPOSES THEREIN SET FORTH.

IN WITNESS WHEREOF, I HAVE HEREUNTO SET MY HAND AND OFFICIAL SEAL THE DAY AND YEAR LAST ABOVE WRITTEN.

*Barbara J. Layton*  
 \_\_\_\_\_  
 BARBARA J. LAYTON, NOTARY PUBLIC

My Commission Expires February 1, 1972.

