


STATE OF KANSAS
STATE CORPORATION COMMISSION

WELL PLUGGING RECORD

Give All Information Completely
Make Required Affidavit
Mail or Deliver Report to:
Conservation Division
State Corporation Commission
P. O. Box 17027
Wichita, Kansas 67217
NORTH

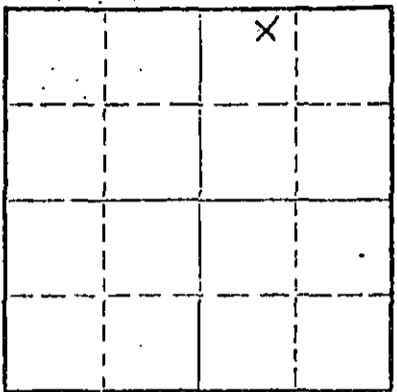

Locate well correctly on above Section Plat

Kingman County, Sec 17 Twp. 29S Rge. 7 (E) W (W)
Location as "NE/CNWKSW" or footage from lines NE/4 NW/4 NE/4
Lease Owner Robert F. White
Lease Name Brand (OWWO) Well No. # 1
Office Address 1014 Union Center ; Wihhita, Kans. 67202
Character of Well (completed as Oil, Gas or Dry Hole) Gas
Date well completed February 17 1970
Application for plugging filed May 10 1974
Application for plugging approved May 1974
Plugging commenced May 30 1974
Plugging completed June 5 1974
Reason for abandonment of well or producing formation No longer economic

If a producing well is abandoned, date of last production April 30 1974
Was permission obtained from the Conservation Division or its agents before plugging was commenced? Yes

Name of Conservation Agent who supervised plugging of this well Russell Biberstein
Producing formation Mississippi Depth to top 4145' Bottom 4245' Total Depth of Well 4245' Feet
Show depth and thickness of all water, oil and gas formations.

OIL, GAS OR WATER RECORDS

CASING RECORD

FORMATION	CONTENT	FROM	TO	SIZE	PUT IN	PULLED OUT
	Surface	0	251	8 5/8"	251	None
	4 1/2" casing	0	4245	4 1/2"	4245	1629

Describe in detail the manner in which the well was plugged, indicating where the mud fluid was placed and the method or methods used in introducing it into the hole. If cement or other plugs were used, state the character of same and depth placed, from _____ feet to _____ feet for each plug set.


May 30, 1974 Plugged off bottom. Dumped sand to 4100'. Mixed and dumped 4 sx of cement.
June 5, 1974 Plugged off top. Set 10' rock bridge at 360'. Filled casing and hole from 360' to base of cellar with 3000 lb. P.S.I. ready-mix concrete.

RECEIVED
STATE CORPORATION COMMISSION
JUN 21 1974
CONSERVATION DIVISION
Wichita, Kansas

(If additional description is necessary, use BACK of this sheet)
Name of Plugging Contractor RUSS CASING PULLING, INC.
Address P. O. Box 1082 ; Great Bend, Kansas 67530

STATE OF KANSAS, COUNTY OF Sedgwick, ss.
Robert F. White (employee of owner) or (owner or operator) of the above-described well, being first duly sworn on oath, says: That I have knowledge of the facts, statements, and matters herein contained and the log of the above-described well as filed and that the same are true and correct. So help me God.

(Signature) [Signature]
1014 Union Center, Wichita, Kansas 67202 (Address)

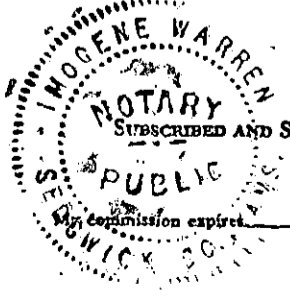

Subscribed and Sworn to before me this 19th day of June, 1974.
Imogene Warren
Notary Public.