

Give All Information Completely  
Make Required Affidavit  
Mail or Deliver Report to:  
Conservation Division  
State Corporation Commission  
211 No. Broadway  
Wichita, Kansas

WELL PLUGGING RECORD

KINGMAN County, Sec. 17 Twp. 29S Rge. ~~XXXXX~~ 7 (W)

Location as "NE/CNW&SW&" or footage from lines NE NW NE

Lease Owner L. E. PHILLIPS, JR., AND J. E. MORRIS

Lease Name BRAND Well No. 1

Office Address 1532 WICHITA PLAZA, WICHITA, KANSAS 67202

Character of Well (completed as Oil, Gas or Dry Hole) DRY HOLE

Date well completed 1 DECEMBER 1965

Application for plugging filed 1 DECEMBER 1965

Application for plugging approved 1 DECEMBER 1965


Plugging commenced 1 DECEMBER 1965

Plugging completed 1 DECEMBER 1965

Reason for abandonment of well or producing formation DRY HOLE

If a producing well is abandoned, date of last production NONE 19   

Was permission obtained from the Conservation Division or its agents before plugging was commenced? YES

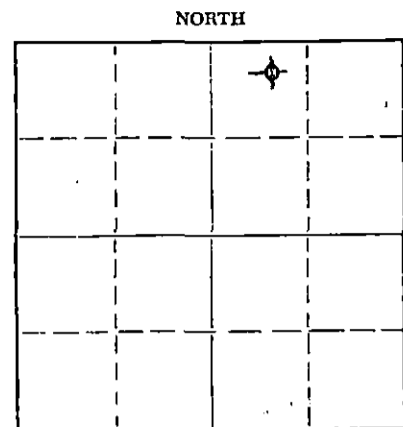

Locate well correctly on above Section Plat

Name of Conservation Agent who supervised plugging of this well ARCHIE ELVING

Producing formation NONE Depth to top     Bottom     Total Depth of Well 4550' Feet

Show depth and thickness of all water, oil and gas formations.

OIL, GAS OR WATER RECORDS

CASING RECORD

FORMATION	CONTENT	FROM	TO	SIZE	PUT IN	PULLED OUT
<u>SURFACE HOLE</u>	<u>WATER</u>	<u>SURFACE</u>	<u>251'RB</u>	<u>8 5/8"OD</u>	<u>246.88'</u>	<u>LEFT IN</u>
<u>(SEE ATTACHED LOG)</u>					<u>12-20-65</u>	
					<u>DEC 20 1965</u>	

Describe in detail the manner in which the well was plugged, indicating where the mud fluid was placed and the method or methods used in introducing it into the hole. If cement or other plugs were used, state the character of same and depth placed, from     feet to     feet for each plug set.

FILLED HOLE WITH HEAVY DRILLING MUD TO 240', BRIDGED HOLE WITH PLUG AND HULLSAND CEMENTED WITH 25 SACKS CEMENT, FILLED HOLE WITH HEAVY DRILLING MUD TO 40', BRIDGED HOLE WITH PLUG AND HULLS AND CEMENTED WITH 10 SACKS CEMENT. PUT 2 SACKS CEMENT IN RAT HOLE.

(If additional description is necessary, use BACK of this sheet)

Name of Plugging Contractor REX & MORRIS DRILLING COMPANY

Address P. O. BOX 334, EL DORADO, KANSAS 67042

STATE OF KANSAS, COUNTY OF BUTLER, ss. A. H. FISHER (employee of owner) or (owner or operator) of the above-described

well, being first duly sworn on oath, says: That I have knowledge of the facts, statements, and matters herein contained and the log of the above-described well as filed and that the same are true and correct. So help me God.

(Signature) A. H. Fisher

P. O. BOX 334, EL DORADO, KANSAS 67042

(Address)

SUBSCRIBED AND SWORN to before me this 16TH day of DECEMBER, 1965

My commission expires 5 MAY 1969

Hazel N. Dilts  
HAZEL N. DILTS  
Notary Public.

BRAND # 1

W. E. PHILLIPS & J. E. MORRIS

Elevation 1629 RB  
1624 GL

Total Depth: 4550' RB  
Contractor: Rex & Morris  
Commenced: 11-18-65  
Completed: 12-1-65  
Initial Prod.: D & A

Location: NE NW NE  
Section 17-298-7W  
Kingman County, Kansas

Casing Record:  
8 5/8" OD Set at 251' RB,  
w/200 sacks

FORMATION	DEPTH
Surface Hole	251'
Shale	1145'
Lime & Shale	2100'
Shale & Lime	2510'
Lime & Shale	2730'
Lime	3160'
Shale - Heebner	3295'
Sand - Douglas	3396'
Lime - Lansing-KC	3875'
Shale	3888'
Lime & Sand	4143'
Lime - Mississippi	4424'
Shale	4534'
Sand - Misner	4536'
Lime - Viola - RTD	4550'

12-20-65  
DEC 20 1965

I hereby certify the foregoing statements are true and correct to the best of my knowledge and belief.

Rex & Morris Drilling Company

By A. H. Fisher  
A. H. Fisher

STATE OF KANSAS  
COUNTY OF BUTLER, SS.

Subscribed and sworn to before me, a Notary Public, this 16th day of December, 1965.

Hazel N. Dilts  
Hazel N. Dilts, Notary Public

My commission expires: May 5, 1969