

RECEIVED
STATE CORPORATION COMMISSION

AUG 18 1982

Form CP-4

STATE OF KANSAS
STATE CORPORATION COMMISSION

Give All Information Completely
Make Required Affidavit
Mail or Deliver Report to:
Conservation Division
State Corporation Commission
211 No. Broadway
Wichita, Kansas


CONSERVATION DIVISION
Wichita, Kansas

WELL PLUGGING RECORD

8-18-82

Kingman County, Sec. 16 Twp. 29S Rge. 7 (W)

NORTH

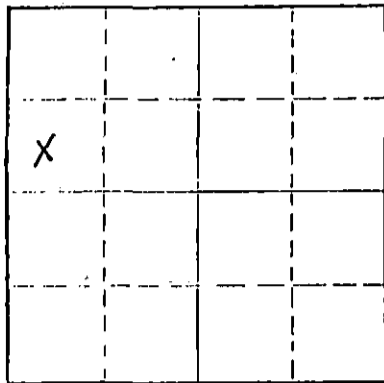

Locate well correctly on above
Section Plat

Location as "NE/CNWKSWK" or footage from lines _____
Lease Owner Monsanto Oil Company
Lease Name Weniger Well No. 1
Office Address 3545 NW 58th St., Oklahoma City, Okla. 73112
Character of Well (completed as Oil, Gas or Dry Hole) Dry Hole
Date well completed _____ 19____
Application for plugging filed April 14 1982
Application for plugging approved May 6 1982
Plugging commenced July 21 1982
Plugging completed July 27 1982
Reason for abandonment of well or producing formation Dry

If a producing well is abandoned, date of last production _____ 19____
Was permission obtained from the Conservation Division or its agents before plugging was commenced? Yes

Name of Conservation Agent who supervised plugging of this well _____

Producing formation None Depth to top _____ Bottom _____ Total Depth of Well 4625 Feet

Show depth and thickness of all water, oil and gas formations.

OIL, GAS OR WATER RECORDS

CASING RECORD

FORMATION	CONTENT	FROM	TO	SIZE	PUT IN	PULLED OUT
				8 5/8	260	None
				4 1/2	4624	2993

Describe in detail the manner in which the well was plugged, indicating where the mud fluid was placed and the method or methods used in introducing it into the hole. If cement or other plugs were used, state the character of same and depth placed, from _____ feet to _____ feet for each plug set.

Hole was filled with heavy drilling fluid. A 35 sack cement plug was placed from 3643' to 4043'. Shot and pulled 4 1/2" casing. Pumped 15 sacks Bentonite, 6 sacks hulls, 10 sacks Betonite and 150 sacks cement down surface to squeeze. Cut off surface pipe three feet below ground level and filled with cement. Welded identification plate on surface pipe.

(If additional description is necessary, use BACK of this sheet)

Name of Plugging Contractor Toland & Johnston
Address P. O. Box 94336, Oklahoma City, Oklahoma 73143

STATE OF Oklahoma, COUNTY OF Oklahoma, ss.

_____, (employee of owner) or ~~owner~~ operator of the above-described well, being first duly sworn on oath, says: That I have knowledge of the facts, statements, and matters herein contained and the log of the above-described well as filed and that the same are true and correct. So help me God.

(Signature) Ernest E. Roll
3545 NW 58th, Okla. City, Okla. 73112
(Address)

SUBSCRIBED AND SWORN to before me this 16th day of August, 1982

My commission expires 9-13-83 _____ Notary Public.