


15-095-00122-0000

STATE OF KANSAS
STATE CORPORATION COMMISSION
Give All Information Completely
Make Required Affidavit
Mail or Deliver Report to:
Conservation Division
State Corporation Commission
211 No. Broadway
Wichita, Kansas

WELL PLUGGING RECORD

Kingman County. Sec. 20 Twp. 29S Rge. 7W (E) (W)

Location as "NE/CNW/SW" or footage from lines C SE NE
Lease Owner Pickrell Drilling Company
Lease Name Oak "C" Well No. 1
Office Address 705 Fourth National Bank Building
Character of Well (completed as Oil, Gas or Dry Hole) Dry Hole
Date well completed 7-27- 19 60
Application for plugging filed " 19 "
Application for plugging approved " 19 "
Plugging commenced " 19 "
Plugging completed " 19 "
Reason for abandonment of well or producing formation D & A

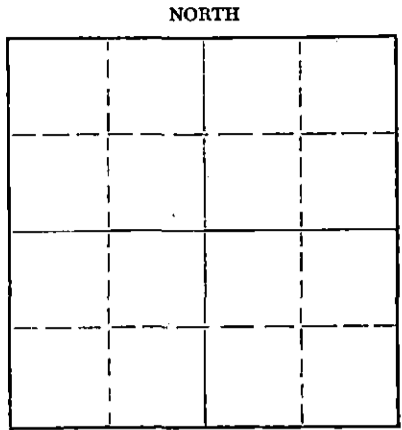

Locate well correctly on above Section Plat

If a producing well is abandoned, date of last production 19
Was permission obtained from the Conservation Division or its agents before plugging was commenced? Yes

Name of Conservation Agent who supervised plugging of this well Fred W. Hampel, Pretty Prairie, Kansas
Producing formation _____ Depth to top _____ Bottom _____ Total Depth of Well 4290 Feet
Show depth and thickness of all water, oil and gas formations.

OIL, GAS OR WATER RECORDS

CASING RECORD

FORMATION	CONTENT	FROM	TO	SIZE	PUT IN	PULLED OUT
				8 5/8"	243'	None

Describe in detail the manner in which the well was plugged, indicating where the mud fluid was placed and the method or methods used in introducing it into the hole. If cement or other plugs were used, state the character of same and depth placed, from _____ feet to _____ feet for each plug set.

Filled with heavy mud to 240'. Bridge hole and cement with 15 sks. Heavy mud to 35', bridge hole and cement with 10 sks. cement to bottom of cellar. Plugged rat hole with 2 sks. of cement.

RECEIVED
STATE CORPORATION COMMISSION
8-3-60
AUG 3 1960
CONSERVATION DIVISION
Wichita, Kansas

Name of Plugging Contractor Pickrell Drilling Company
Address 705 Fourth National Bank Building, Wichita, Kansas

STATE OF Kansas, COUNTY OF Sedgwick, ss.
C. W. Sebitts (employee of owner) or (owner or operator) of the above-described well, being first duly sworn on oath, says: That I have knowledge of the facts, statements, and matters herein contained and the log of the above-described well as filed and that the same are true and correct. So help me God.

(Signature) [Signature]
705 Fourth National Bank Bldg., Wichita, Kansas
(Address)

SUBSCRIBED AND SWORN TO before me this 1 st day of August, 19 60

My commission expires September 24, 1962
Maxine Johnson Notary Public.

ROTARY DRILLING LOG

COMPANY: Pickrell Drilling Company
705 Fourth National Bank Bldg.
Wichita, Kansas

Rotary Drilling Commenced 7-8-60

Rotary Drilling Completed 7-27-60

LOCATION: Oak "C" #1 C SE NE
XXXXXX Section 20-29S-7W
Kingman County, Kansas

CONTRACTOR: PICKRELL DRILLING COMPANY
Wichita, Kansas

CASING RECORD: Ran 12 jts. 8 5/8" Smls. Casing. Set at 243', cemented with 115 sks.
Cement circulated.

No Oil String: D & A

LOG

(Figures indicate bottom of formation — measurements from top of rotary bushing.)

Depth	Formation	Circulated for Samples
885	Red Bed & Shale	
950	Shale, Clay & Gyp	
1300	Shale, Salt & Shells	3712'
2975	Lime & Shale	3782'
3400	Lime, Shale & Sand	3812'
3518	Lime & Shale	3851'
3887	Lime	4168'
4179	Lime & Shale	4174'
4290	Mississippi & T. D.	4185'
		4204'
		4210'
		4240'
		4250'
		4290'

Slope Tests

2000	0°
3000	0°
3500	0°

S. L. M.

1500	OK
3000	OK
3500	OK

RECEIVED
STATE CORP
8-3-60
AUG 3 1960
CONSERVATION DIVISION
Wichita, Kansas

The undersigned, C. W. Sebitts, Attorney-in-Fact for PICKRELL DRILLING COMPANY, hereby certifies in behalf of said Company, that the above is a true and correct log of the formation encountered in drilling the above well as reflected by the Daily Drilling Reports.

PICKRELL DRILLING COMPANY
By: [Signature]
Partner

STATE OF KANSAS }
COUNTY OF SEDGWICK } ss:

On this 1 st day of August, 19 60, before me the undersigned, a Notary Public, in and for

the County and State aforesaid, personally appeared C. W. Sebitts, to me known to be the identical person who subscribed the name of PICKRELL DRILLING COMPANY to the foregoing instrument as its Attorney-in-Fact and acknowledged to me that he executed the same as his free and voluntary act and deed, and as the free and voluntary act and deed of such company, for the uses and purposes therein set forth.

Given under my hand and seal of office the day and year last above written.

My commission expires September 24, 1962.

[Signature]
Notary Public
Maxine Johnson