

STATE OF KANSAS
STATE CORPORATION COMMISSION


Form CP-4

Give All Information Completely
Make Required Affidavit
Mail or Deliver Report to:
Conservation Division
State Corporation Commission
212 No. Market
Wichita, Kansas 67202

WELL PLUGGING RECORD

Kingman County, Sec. 22 Twp. 29S Rge. 7 (E) (W)

Location as "NE/CNW/SW" or footage from lines NE NW NE
Lease Owner Robert F. White
Lease Name Endicott Well No. 3
Office Address 714 Union Center, Wichita, Kansas 67202
Character of Well (completed as Oil, Gas or Dry Hole) Gas
Date well completed December 14 19 66
Application for plugging filed June 3 19 71
Application for plugging approved 19
Plugging commenced 6/24/71 19
Plugging completed 6/29/71 19
Reason for abandonment of well or producing formation No longer economic

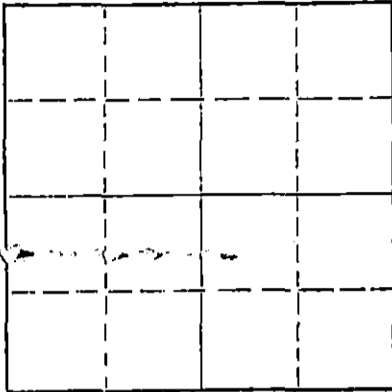

Locate well correctly on above
Section Plat

If a producing well is abandoned, date of last production February 1 19 71
Was permission obtained from the Conservation Division or its agents before plugging was commenced? Yes

Name of Conservation Agent who supervised plugging of this well Biberstein
Producing formation Mississippi Depth to top 4140 Bottom 4161 Total Depth of Well 4161 Feet
Show depth and thickness of all water, oil and gas formations. (Perf. 4148-50)

OIL, GAS OR WATER RECORDS

CASING RECORD

FORMATION	CONTENT	FROM	TO	SIZE	PUT IN	PULLED OUT
		0	402	8-5/8	402	None
		0	4517	4-1/2	4517	3634'

Describe in detail the manner in which the well was plugged, indicating where the mud fluid was placed and the method or methods used in introducing it into the hole. If cement or other plugs were used, state the character of same and depth placed, from _____ feet to _____ feet for each plug set.

Checked hole to 4517', pushed plug to 4150' and ran 20' of sand and 3 sacks of cement. Loaded hole with water, shot pipe at 3964', 3670', got loose and pulled 114 joints. Set 10' rock bridge at 300' and ran 5 yards concrete.

PLUGGING COMPLETE.

RECEIVED
STATE CORPORATION COMMISSION
JUL 22 1971
CONSERVATION DIVISION
Wichita, Kansas
7-22-71


(If additional description is necessary, use BACK of this sheet)
Name of Plugging Contractor KNIGHT CASING PULLING CO., INC.
Address CHASE, KANSAS

STATE OF KANSAS, COUNTY OF RICE, ss.
NOEL J. KNIGHT (employee of owner) or (owner or operator) of the above-described well, being first duly sworn on oath, says: That I have knowledge of the facts, statements, and matters herein contained and the log of the above-described well as filed and that the same are true and correct. So help me God.

(Signature) Noel Knight
CHASE, KANSAS
(Address)

Subscribed and sworn to before me this 15th day of July, 19 71

My commission expires

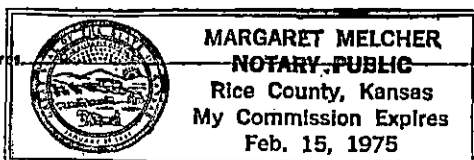

Margaret Melcher
Notary Public.

ROTARY DRILLING LOG

OWNER: Gralapp & Sverly
 CONTRACTOR: Prime Drilling Company
 LEASE: ~~Endicott #3~~
 LOCATION: Section 22-29S-7W
 Kingman County, Kansas

CASING: Set 8 5/8" surface casing
 @ 402, 300 sz Pozmix HA-5

Set 4 1/2 casing at 4519

RECEIVED
 STATE CORPORATION COMMISSION
 JUN 4 1971
 CONSERVATION DIVISION
 Wichita, Kansas

0 - 40	Soil & Sand
40 - 440	Red Bed
440 - 1130	Shale & Shells
1130 - 1145	Anhydrite
1145 - 1195	Shale & Shells
1195 - 1300	Anhydrite & Shale
1300 - 1557	Lime
1557 - 1620	Shale & Lime Streaks
1620 - 1718	Lime & Shale Streaks
1718 - 1977	Lime
1977 - 2150	Shale & Lime Streaks
2150 - 2200	Lime & Shale
2200 - 2238	Lime
2238 - 2375	Lime & Shale
2375 - 2477	Lime
2477 - 2670	Shale & Lime Streaks
2670 - 2840	Lime & Shale
2840 - 2978	Lime
2978 - 3128	Shale & Lime Streaks
3128 - 3280	Shale & Lime
3280 - 3335	Sand
3335 - 3360	Lime & Shale
3360 - 3810	Lime
3810 - 4010	Shale & Lime
4010 - 4085	Lime
4085 - 4142	Shale & Lime
4142 - 4178	Mississippi Chat
4178 - 4414	Mississippi Lime
4414 - 4446	Kind. Shale
4446 - 4521	Shale
4521	Rotary Total Depth

Set 4 1/2" casing @ 4519',
 100 sz Pozmix, salt saturated

Drilled Cable Tools
 to 4532 TDH. 7W, SIMP SAND 4531.

We certify that the above log is true and correct to the best of our knowledge and belief.

PRIME DRILLING COMPANY


 L. J. Clappitt