

STATE OF KANSAS
STATE CORPORATION COMMISSION

WELL PLUGGING RECORD

Give All Information Completely.
Make Required Affidavit
Mail or Deliver Report to
Conservation Division
State Corporation Comm.
245 North Water
Wichita, KS 67202

Kingman County, Sec. 25 Twp. 29S Rge. 7 ~~W~~/W
Location as "NE/CNW $\frac{1}{4}$ /SW $\frac{1}{4}$ " or footage from lines
200' W C SE SW

Lease Owner Western Drilling & Exploration, Inc.
Lease Name Millard Well No. 1

Office Address 439 Wheatland Place, Wichita, Kansas 67235
Character of Well (Completed as Oil, Gas or Dry Hole)


Dry Hole

Date Well completed August 2, 19 79
Application for plugging filed August 2, 19 79
Application for plugging approved August 2, 19 79
Plugging commenced August 2, 19 79
Plugging completed August 2, 19 79
Reason for abandonment of well or producing formation

If a producing well is abandoned, date of last production 19

Was permission obtained from the Conservation Division or its agents before plugging was commenced? Yes

Name of Conservation Agent who supervised plugging of this well Wm. T. Owen, Pratt, Kansas
Producing formation Depth to top Bottom Total Depth of Well 4240
Show depth and thickness of all water, oil and gas formations.

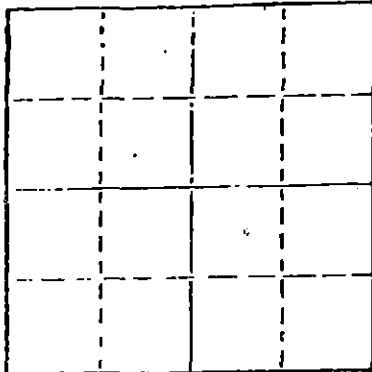

Locate well correctly on above Section Plat

OIL, GAS OR WATER RECORDS

CASING RECORD

FORMATION	CONTENT	FROM	TO	SIZE	PUT IN	PULLED OUT

Describe in detail the manner in which the well was plugged, indicating where the mud fluid was placed and the method or methods used in introducing it into the hold. If cement or other plugs were used, state the character of same and depth placed, from feet to feet for each plug set.

Pumped 40 sacks cement through drill pipe at 210'. Pushed plug and 1/2 sack hulls to 40 feet and 12 sacks cement. Plugged rat hole with 3 sacks cement.

RECEIVED
STATE CORPORATION COMMISSION

AUG - 9 1979

8-9-79

CONSERVATION DIVISION
WICHITA, KANSAS

(If additional description is necessary, use BACK of this sheet)

Name of Plugging Contractor Graves Drilling Co., Inc.

STATE OF KANSAS COUNTY OF SEDGWICK, ss.

John C. Graves (employee of owner) or (owner or operator) of the above-described well, being first duly sworn on oath, says: That I have knowledge of the facts, statements, and matters herein contained and the log of the above-described well as filed and that the same are true and correct. So help me God.

(Signature)

910 Union Center, Wichita, Kansas 67202
(Address)

SUBSCRIBED AND SWORN TO before me this 8th day of August, 19 79

Betty Brandt Notary Public.

My commission expires May 9, 1983

ROTARY DRILLERS' LOG

OPERATOR: Western Drilling & Exploration, Inc. DRILLING COMMENCED: July 26, 1979
439 Wheatland Place
Wichita, Kansas 67235

CONTRACTOR: Graves Drilling Co., Inc. DRILLING COMPLETED: August 3, 1979
910 Union Center
Wichita, Kansas 67202

CASING RECORD: 5 Jts. 2 1/2' of new 8-5/8" cemented with 225 sacks. LOCATION: Millard No. 1
200' W C SE SW
Section 25-29S-7W
Kingman County, Kansas

0 - 60	Sand
60 - 220	Red bed
220 - 3993	Shale & lime
3993 - 4150	Lime & shale
4150 - 4195	Lime & chert
4195 - 4240	Chert
4240	Rotary Total Depth

I hereby certify the foregoing statements to be true and correct to the best of my knowledge.

GRAVES DRILLING CO., INC.

By *Philip Graves* President

RECEIVED
STATE CORPORATION COMMISSION
AUG - 9 1979
CHIEF CLERK DIVISION
Wichita, Kansas

STATE OF KANSAS)
) ss.
SEDGWICK COUNTY)

Subscribed and sworn to before me, a Notary Public, this 8th day of August, 1979.

My commission expires: May 9, 1983

Betty Brandt
Betty Brandt Notary Public