


STATE OF KANSAS STATE CORPORATION COMMISSION

SEP 29 1982

WELL PLUGGING RECORD

Give All Information Completely Make Required Affidavit Mail or Deliver Report to Conservation Division State Corporation Comm. 245 North Water Wichita, KS 67202

Seward CONSERVATION DIVISION County of Seward Twp. 32 Rge. 34 E/W Location as NE/CNW1SW1 or footage from lines C SE/4 SE/4 Lease Owner Cities Service Company Lease Name Marteney C Well No. 1 Office Address 3545 N.W. 58th Street, Okla. City, OK 73112 Character of Well (Completed as Oil, Gas or Dry Hole) Dry Hole Date Well completed 6-8- 19 82 Application for plugging filed 8-25 19 82 Application for plugging approved 9-9- 19 82 Plugging commenced 9-2- 19 82 Plugging completed 9-2- 19 82 Reason for abandonment of well or producing formation Dry Hole If a producing well is abandoned, date of last production N/A 19

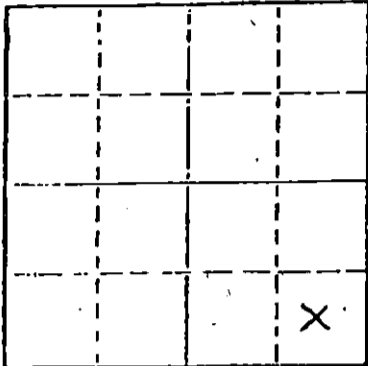

Locate well correctly on above Section Plot

Name of Conservation Agent who supervised plugging of this well Steve Durrant Producing formation: None Depth to top Bottom Total Depth of Well 6340' Show depth and thickness of all water, oil and gas formations.

OIL, GAS OR WATER RECORDS

CASING RECORD

Table with 7 columns: FORMATION, CONTENT, FROM, TO, SIZE, PUT IN, PULLED OUT. Row 1: 8-5/8", 1697', None. Row 2: 5-1/2", 4350', 2207'.

Describe in detail the manner in which the well was plugged, indicating where the mud fluid was placed and the method or methods used in introducing it into the hold. If cement or other plugs were used, state the character of same and depth placed, from feet to feet for each plug set.

Open hole cement plugs prior to running production string spotted as follows: 55 sx 5735-5900'; 50 sx 4750-4900'; 5-1/2" casing at 4350'.

PLUGGING: Set cast iron bridge plug @ 3815' capped with 1 sx cmt (above perf's 4180-86'; shot off 5-1/2" casing at 2207'. Spotted cmt plugs as follows: 25 sx 2107-2207; 50 sx 1635-1735'; 25 sx 653-753; 10 sx 4-40'. Drilling mud between plugs. Cut off 8-5/8" casing 4' below ground level and welded on steel cap with well name and date.

(If additional description is necessary, use BACK of this sheet)

Name of Plugging Contractor Daco, Inc.

STATE OF Oklahoma COUNTY OF Oklahoma ss. Verlin Meier (employee of owner) or (owner or operator)

of the above-described well, being first duly sworn on oath, says: That I have knowledge of the facts, statements, and matters herein contained and the log of the above-described well as filed and that the same are true and correct. So help me God.

Verlin Meier - Production Region Manager (Signature) 3545 N.W. 58th St., -Oklahoma City, OK 73112 (Address)

SUBSCRIBED AND SWORN TO before me this 27th day of September, 19 82

My commission expires July 12, 1984

Notary Public.

15-175-20596-0000

JOHNSON *Drilling Company, Inc.*



OFFICES IN
EVANSVILLE, INDIANA
TEL. (812) 424-8291
OKLAHOMA CITY, OKLAHOMA
TEL. (405) 943-7667
LIBERAL, KANSAS
TEL. (316) 624-7731
REPLY TO:

3535 N. W. 58th - Suite 710
Oklahoma City, Oklahoma 73112

March 23, 1982

CITIES SERVICE COMPANY
P. O. BOX 682
BEAVER, OKLAHOMA 73932

ATTN: F. A. GIBSON

RECEIVED
STATE CORPORATION COMMISSION
AUG 26 1982
CONSERVATION DIVISION
Wichita, Kansas

DRILLERS LOG for:

MARTENEY "C" # 1

0' - 340'
340' - 1688'
1688' - 1698'
1698' - 2745'
2745' - 6340'

Surface, Clay, & Sand
Redbed, Sand, & Shale
Anhydrite
Shale
Lime & Shale

JOHNSON DRILLING COMPANY, INC.

Signed by: *Claude D. Moore*
Claude D. Moore, Manager

STATE OF OKLAHOMA:

COUNTY OF OKLAHOMA:

Subscribed and sworn to before me this 23rd day of March, 1982.

Barbara J. Foley Notary Public

My Commission Expires: *October 24, 1984*