


Give All Information Completely
Make Required Affidavit
Mail or Deliver Report to:
Conservation Division
State Corporation Commission
212 No. Market
Wichita, Kansas

WELL PLUGGING RECORD

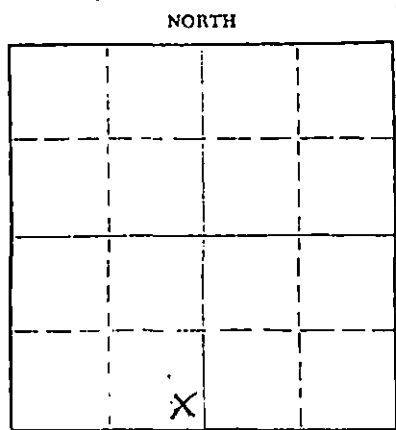

Locate well correctly on above
Section Plat

Seward County. Sec. 23 Twp. 32 Rge. 34 WEX (W)
Location as "NE/CNWxSWx" or footage from lines SE SE SW
Lease Owner CITIES SERVICE OIL & GAS CO.
Lease Name Baughman "X" Well No. #1
Office Address Box 850, Sublette, KS 67877
Character of Well (completed as Oil, Gas or Dry Hole) Dry Hole
Date well completed 5-2 1985
Application for plugging filed 8-1 1985
Application for plugging approved 8-5 19 85
Plugging commenced 8-19 19.85
Plugging completed 8-20 19.85
Reason for abandonment of well or producing formation Dry Hole

If a producing well is abandoned, date of last production 19
Was permission obtained from the Conservation Division or its agents before plugging was commenced? yes

Name of Conservation Agent who supervised plugging of this well _____
Producing formation _____ Depth to top _____ Bottom _____ Total Depth of Well 6450 Feet
Show depth and thickness of all water, oil and gas formations.

OIL, GAS OR WATER RECORDS

CASING RECORD

FORMATION	CONTENT	FROM	TO	SIZE	PUT IN	PULLED OUT
				8-5/8"	1705'	None
				5-1/2"	6499'	2420'

Describe in detail the manner in which the well was plugged, indicating where the mud fluid was placed and the method or methods used in introducing it into the hole. If cement or other plugs were used, state the character of same and depth placed, from _____ feet to _____ feet for each plug set.

Load casing with 94 bbls. 9.5# mud, shot casing at 2420', pumped 50 sks. common cement from 2430' to 2330', pumped 50 bbls. displacement, pumped 50 sks. common cement from 1735' to 1635', pumped 42 bbls. displacement, pumped 35 sks. common cement from 650' to 550', pumped 15 bbls. 9.5# mud, pumped 10 sks. common cement from 40' to surface.

(If additional description is necessary, use BACK of this sheet)
Name of Plugging Contractor DACO, INC.
Address P. O. Drawer 3010, Borger, TX 79008-3010

STATE OF Texas COUNTY OF Hutchinson, ss.
JACK PAINTER (employee of owner) or (owner or operator) of the above-described well, being first duly sworn on oath, says: That I have knowledge of the facts, statements, and matters herein contained and the log of the above-described well as filed and that the same are true and correct. So help me God.

(Signature) Jack Painter, Agent
Drawer 3010, Borger, TX 79008-3010
(Address)

SUBSCRIBED AND SWORN TO before me this 6th day of September, 19 85

My commission expires 8-3-89

Judy Stark
Notary Public.



JUDY E. STARK
Notary Public, State of Texas
My Commission Expires 8-3-89

RECEIVED
STATE CORPORATION COMMISSION

SEP 26 1985

CONSERVATION DIVISION
Wichita, Kansas