

15-175-00029-0001


STATE OF KANSAS
STATE CORPORATION COMMISSION

Form CP-4

WELL PLUGGING RECORD

Give All Information Completely
Make Required Affidavit
Mail or Deliver Report to:
Conservation Division
State Corporation Commission
212 No. Market
Wichita, Kansas

NORTH

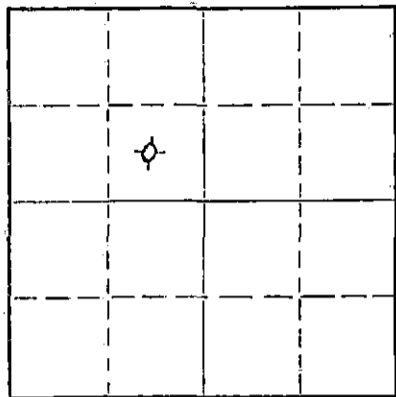

Locate well correctly on above
Section Plat

Seward County. Sec. 25 Twp. 32S Rge. (E) 34 (W)
Location as "NE/CNW/SW" or footage from lines 1980' from N & W lines
Lease Owner Coral Gas and Oil, Inc.
Lease Name Government Well No. 1
Office Address 409 Bank of Southwest Bldg., Amarillo, Tex. 79109
Character of Well (completed as Oil, Gas or Dry Hole) Gas
Date well completed January 4, 1970
Application for plugging filed October 12, 1970
Application for plugging approved October 13, 1970
Plugging commenced November 27, 1970
Plugging completed November 27, 1970
Reason for abandonment of well or producing formation Water entry made
production uneconomical
If a producing well is abandoned, date of last production Never produced 19
Was permission obtained from the Conservation Division or its agents before plugging was commenced? Yes

Name of Conservation Agent who supervised plugging of this well

Producing formation Morrow Depth to top 5758 Bottom 5767 Total Depth of Well 5900 Feet

Show depth and thickness of all water, oil and gas formations.

OIL, GAS OR WATER RECORDS

CASING RECORD

FORMATION	CONTENT	FROM	TO	SIZE	PUT IN	PULLED OUT
Morrow	Gas & water	5758	5767	13-3/8	459	None
				8-5/8	2792	1420
				4-1/2	5900	2015

Describe in detail the manner in which the well was plugged, indicating where the mud fluid was placed and the method or methods used in introducing it into the hole. If cement or other plugs were used, state the character of same and depth placed, from _____ feet to _____ feet for each plug set.

Filled hole with mud to 5767'. Mixed and pumped 20 sacks cement with plug from 5767' to 5509'. Pumped mud to 460'. Spotted 80 sacks cement from 460' to 360'. Pumped mud to 34'. Ran 20 sacks cement from 34' to 4'.

RECEIVED
STATE CORPORATION COMMISSION
DEC 21 1970
CONSERVATION DIVISION
Wichita, Kansas

(If additional description is necessary, use BACK of this sheet)

Name of Plugging Contractor Daco Lease & Well Service
Address 1700 South Main, Borger, Texas 79007

STATE OF Texas, COUNTY OF Potter, ss.

Bryan Dawson (employee of owner) or (owner or operator) of the above-described well, being first duly sworn on oath, says: That I have knowledge of the facts, statements, and matters herein contained and the log of the above-described well as filed and that the same are true and correct. So help me God.

(Signature)

Bryan Dawson

409 Bank of the Southwest Bldg.

(Address) Amarillo, Texas 79109

SUBSCRIBED AND SWORN TO before me this 15th day of December, 19 70

Layne Fluty

Notary Public.

My commission expires June 1, 1971