

15-175-20728-0000

STATE OF KANSAS
STATE CORPORATION COMMISSION


Form CP-4

Give All Information Completely
Make Required Affidavit
Mail or Deliver Report to:
Conservation Division
State Corporation Commission
P. O. Box 17027
Wichita, Kansas 67217
NORTH

WELL PLUGGING RECORD

Seward County, Sec. 35 Twp. 32S Rge. ~~32E~~ 34(W)

Location as "NE/CNW/SW" or footage from lines C NW NW
Lease Owner Petroleum Inc.
Lease Name Federal Land Bank Well No. #1
Office Address P. O. Box 1255 Liberal, KS 67901
Character of Well (completed as Oil, Gas or Dry Hole) Dry hole
Date well completed 1/11 1984
Application for plugging filed 1/ 1984
Application for plugging approved 19
Plugging commenced 1/10 1984
Plugging completed 1/11 1984
Reason for abandonment of well or producing formation Dry hole

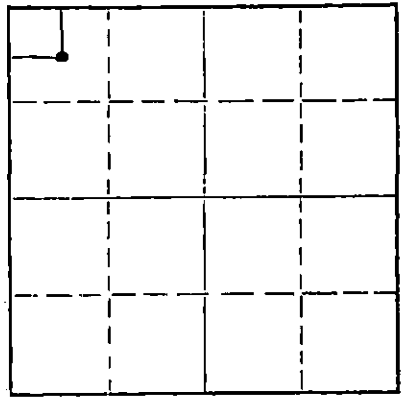

If a producing well is abandoned, date of last production 19
Was permission obtained from the Conservation Division or its agents before plugging was commenced? Yes

Name of Conservation Agent who supervised plugging of this well Steve Durrant
Producing formation Depth to top Bottom Total Depth of Well 6335 Feet
Show depth and thickness of all water, oil and gas formations.

OIL, GAS OR WATER RECORDS

CASING RECORD

| FORMATION | CONTENT | FROM | TO | SIZE | PUT IN | PULLED OUT |
|-----------|---------|------|----|-------|--------|------------|
| | | | | 8 5/8 | 1635 | None |
| | | | | | | |
| | | | | | | |
| | | | | | | |
| | | | | | | |
| | | | | | | |
| | | | | | | |
| | | | | | | |

Describe in detail the manner in which the well was plugged, indicating where the mud fluid was placed and the method or methods used in introducing it into the hole. If cement or other plugs were used, state the character of same and depth placed, from feet to feet for each plug set.

50 sx. @ 3170'
50 sx. @ 2550'
40 sx. @ 1680'
40 sx. @ 750'
10 sx. @ 40-surface
10 sx. rathole
10 sx. mousehole
Cemented w/60-40 poz. Job completed 10:30 a.m. 1/11/84

(If additional description is necessary, use BACK of this sheet)

Name of Plugging Contractor Halliburton
Address Liberal, KS

STATE OF Kansas, COUNTY OF Seward, ss.
Steve Phillips (employee of owner) or (owner or operator) of the above-described well, being first duly sworn on oath, says: That I have knowledge of the facts, statements, and matters herein contained and the log of the above-described well as filed and that the same are true and correct. So help me God.

(Signature) Steven L. Phillips

P. O. Box 1255 Liberal, KS 67901 (Address)

SUBSCRIBED AND SWORN to before me this 16th day of January, 1984

NOTARY PUBLIC - State of Kansas
JAMES R. HATFIELD
My Appt. Exp. 2/25/86

James R. Hatfield

Notary Public.

RECEIVED

STATE CORPORATION COMMISSION

JAN 18 1984

CONSERVATION DIVISION