


STATE OF KANSAS
STATE CORPORATION COMMISSION

WELL PLUGGING RECORD

Give All Information Completely
Make Required Affidavit
Mail or Deliver Report to
Conservation Division
State Corporation Comm.
245 North Water
Wichita, KS 67202

Meade County, Sec. 9 Twp. 32 Rge. 29 E/W
Location as "NE/CNW $\frac{1}{4}$ /SW $\frac{1}{4}$ " or footage from lines
1520 FNL and 2490 FWL
Lease Owner NATURAL GAS ANADARKO, Inc.
Lease Name Demmitt Well No. 1-9
Office Address Box 809, Perryton, Texas 79070
Character of Well (Completed as Oil, Gas or Dry Hole)
Dry Hole

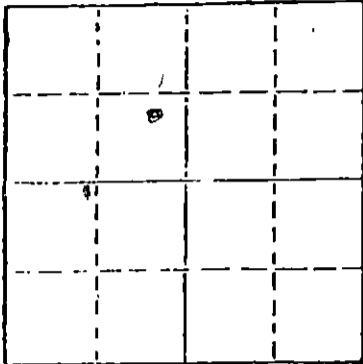

Locate well correctly on above
Section Plat

Date Well completed 19
Application for plugging filed 19
Application for plugging approved 19
Plugging commenced 7-19- 19 78
Plugging completed 7-19-78 19 78
Reason for abandonment of well or producing formation
Dry Hole

If a producing well is abandoned, date of last production 19

Was permission obtained from the Conservation Division or its agents before plugging was commenced? Yes

Name of Conservation Agent who supervised plugging of this well Clarence Thomas
Producing formation Depth to top Bottom Total Depth of Well 5760
Show depth and thickness of all water, oil and gas formations.

OIL, GAS OR WATER RECORDS

CASING RECORD

FORMATION	CONTENT	FROM	TO	SIZE	PUT IN	PULLED OUT

Describe in detail the manner in which the well was plugged, indicating where the mud fluid was placed and the method or methods used in introducing it into the hold. If cement or other plugs were used, state the character of same and depth placed, from feet to feet for each plug set.

1st Plug	@1200' with 60 sacks cement
2nd Plug	@ 600' with 35 sacks cement
3rd plug	@ 40' with 12 sacks cement

RECEIVED
STATE CORPORATION COMMISSION

(If additional description is necessary, use BACK of this sheet)

Name of Plugging Contractor Zenith Drilling Corporation, Inc. JAN 20 1979

STATE OF Texas COUNTY OF Ochiltree CONSERVATION DIVISION
Wichita, Kansas, ss.
(employee of owner) or (owner or operator)

of the above-described well, being first duly sworn on oath, says: That I have knowledge of the facts, statements, and matters herein contained and the log of the above-described well as filed and that the same are true and correct. So help me God.

(Signature) [Signature]
Box 809, Perryton, Texas 79070
(Address)

SUBSCRIBED AND SWORN TO before me this 25 day of January, 1979.

[Signature]
Notary Public.

My commission expires 9/30/80

WELL LOG

COMPANY Natural Gas Anadarko, Inc.

SEC. 9-32S-29W

FARM Demmitt

NO. 1-9

LOC. 1520' FNL & 2490' FWL


TOTAL DEPTH 5760'

COUNTY Meade

COMM. 7-06-78

COMP. 7-19-78

CONTRACTOR Zenith Drilling Corporation, Inc.

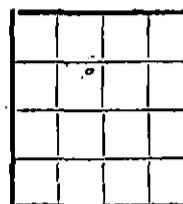

CASING
1608' of 8 5/8" 24# casing, cemented with
800 sacks cement.

ELEVATION

PRODUCTION

FIGURES INDICATE BOTTOM OF FORMATIONS

800	Sand & Red Bed
1410	Sand, Red Bed & Anhydrite
1609	Sand & Anhydrite
2039	Shale & Sand
4325	Shale & Lime
4495	Lime
5760	Shale & Lime

PLUGGING INFORMATION:

1st Plug @ 1200' with 60 sacks cement
 2nd Plug @ 600' with 35 sacks cement
 3rd Plug @ 40' with 12 sacks cement

5 sacks in the rat hole. Job complete @
 10:45 A.M. 7-19-78

RECEIVED
STATE CORPORATION COMMISSION

JAN 29 1979

CONSERVATION DIVISION
Wichita, Kansas

State of KANSAS }
 County of SEDGWICK } 88

I, Emmet E. Hall of Zenith Drilling Corporation, Inc.

upon oath state the above and foregoing is a true and correct copy of the log of the Demmitt #1-19 well.

Emmet E. Hall

Subscribed and sworn to before me this 1st day of August, 1978.

My Commission Expires: December 15, 1980

Sharon R. Allen

Sharon R. Allen NOTARY PUBLIC