


15-119-10134-0000

STATE OF KANSAS
STATE CORPORATION COMMISSION

Give All Information Completely
Make Required Affidavit
Mail or Deliver Report to:
Conservation Division
State Corporation Commission
211 No. Broadway
Wichita, Kansas

WELL PLUGGING RECORD

NORTH

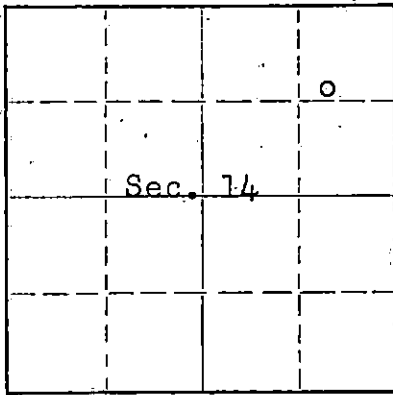

Locate well correctly on above
Section Plat

MEADE

County. Sec. 14 Twp. 32 Rge. 29 (E) W (W)

Location as "NE/CNW/SW" or footage from lines APP. SW NE NE

Lease Owner PETROLEUM, INC.

Lease Name SANDERS "C"

Well No. 1

Office Address ROUTE 2, GREAT BEND, KANSAS

Character of Well (completed as Oil, Gas or Dry Hole) DRY HOLE

Date well completed December 28, 19 57

Application for plugging filed December 30, 19 57

Application for plugging approved December 30, 19 57

Plugging commenced December 28, 19 57

Plugging completed December 28, 19 57

Reason for abandonment of well or producing formation

No Producing Zones

If a producing well is abandoned, date of last production None 19

Was permission obtained from the Conservation Division or its agents before plugging was commenced? Yes

Name of Conservation Agent who supervised plugging of this well M.A. Rives, Box 8, Pratt, Kansas

Producing formation ----- Depth to top --- Bottom ----- Total Depth of Well 5700' Feet

Show depth and thickness of all water, oil and gas formations.

OIL, GAS OR WATER RECORDS

CASING RECORD

FORMATION	CONTENT	FROM	TO	SIZE	PUT IN	PULLED OUT.
				8-5/8"	1458'	None

Describe in detail the manner in which the well was plugged, indicating where the mud fluid was placed and the method or methods used in introducing it into the hole. If cement or other plugs were used, state the character of same and depth placed, from _____ feet to _____ feet for each plug set.

Mud up with heavy mud to 450' followed by wooden plug. Placed 20 sacks cement through drill pipe on to plug. Mud up to 30' followed by wooden plug and 10 sacks cement to base of well cellar.

RECEIVED
STATE CORPORATION COMMISSION

JAN 9 1958

CONSERVATION DIVISION
Wichita, Kansas

(If additional description is necessary, use BACK of this sheet)

Name of Plugging Contractor GARVEY DRILLING COMPANY
Address ROUTE 2, GREAT BEND, KANSAS

STATE OF KANSAS, COUNTY OF BARTON, ss.

Don Searle (employee of owner) or (owner or operator) of the above-described well, being first duly sworn on oath, says: That I have knowledge of the facts, statements, and matters herein contained and the log of the above-described well as filed and that the same are true and correct. So help me God.

(Signature)

Don Searle

ROUTE 2, GREAT BEND, KANSAS

(Address)

SUBSCRIBED AND SWORN TO before me this 7th day of January, 19 58

Notary Public.

My commission expires July 11, 1960

PLUGGING
FILE SEC 14 T 32 R 290
BOOK PAGE 42 LINE 38

15-119-10134-0000

WELL LOG

COMPANY PETROLEUM, INCORPORATED

SEC. 14 T. 32S R. 29W

FARM SANDERS "C" NO. 1


LOC. SW, NE, NE

TOTAL DEPTH 5700'

COUNTY MEADE CO., KANSAS

COMM. November 30, 1957 COMP. December 28, 1957

CONTRACTOR GARVEY DRILLING COMPANY

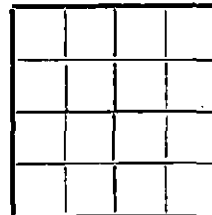

CASING 8 5/8" @ 1458' W/1025 sax.

ELEVATION 2655' KB

PRODUCTION D & A

FIGURES INDICATE BOTTOM OF FORMATIONS

40	Surface clay & sand
380	Shale
555	Sand & shale
910	Red bed, lime & shells
1305	Shale & red bed
1414	Red bed & sand
1640	Anhydrite
1836	Red bed & shale
2055	Shale
2170	Sand shale & shells
2380	Shale & lime
2534	Shale, lime & anhydrite
2609	Lime & chalk
2773	Lime & shale
2866	Sandy lime
3028	Shale & lime
XX 3122	Lime
3325	Lime & shale
3420	Lime
3725	Lime & shale
3819	Lime
4000	Lime, shale & sand
4025	Soft chalky lime
4341	Lime & shale
4372	Shale
4575	Shale & lime
4714	Lime
4737	Lime & shale
4995	Lime
5465	Shale & lime
5526	Lime
5700	Lime & shale
5700	T. D.

RECEIVED
STATE CORPORATION COMMISSION

JAN 9 1958

CONSERVATION DIVISION
Wichita, Kansas

PLUGGING
 FILE SEC. 14 T. 32 R. 29W
 BOOK PAGE 72 LINE 38

State of KANSAS)
County of BARTON) ss:

I, VERNE A. MORRIS of GARVEY DRILLING CO.

upon oath state that the above and foregoing is a true and correct copy of the log of the #1 SANDERS "C" well

Verne A. Morris

Subscribed and sworn to before me this 7th day of January 19 58

My Commission Expires: July 11, 1960

Delbert Brown
NOTARY PUBLIC