


STATE OF KANSAS
STATE CORPORATION COMMISSION

Give All Information Completely
Make Required Affidavit
Mail or Deliver Report to:
Conservation Division
State Corporation Commission
212 North Market, Insurance Bldg.
Wichita, Kansas

15-119-00116-0000

WELL PLUGGING RECORD

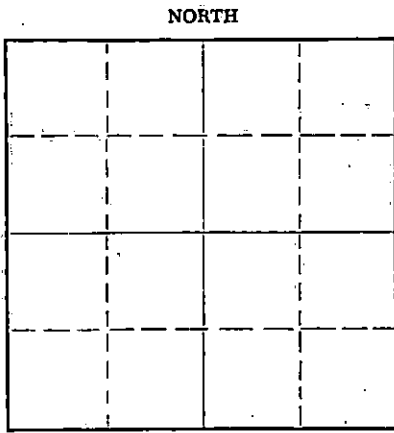

Locate well correctly on above
Section Plat

Meade County, Sec. 15 Twp. 32 Rge. (E) 29 (W)
Location as "NE/CNW/SW" or footage from lines: C SW/4 NE/4
Lease Owner Youngblood & Youngblood
Lease Name Gollimer Well No. 1
Office Address Box 552, Oklahoma City, Oklahoma
Character of Well (completed as Oil, Gas or Dry Hole) Dry Hole
Date well completed November 15 1960
Application for plugging filed November 14 1960
Application for plugging approved November 14 1960
Plugging commenced November 15 1960
Plugging completed 5:15 p. m. November 15 1960
Reason for abandonment of well or producing formation
Dry Hole

If a producing well is abandoned, date of last production 19
Was permission obtained from the Conservation Division or its agents before plugging was commenced? Yes

Name of Conservation Agent, who supervised plugging of this well W. L. LaKamp, Jr.
Producing formation None Depth to top Bottom Total Depth of Well 5800 Feet
Show depth and thickness of all water, oil and gas formations.

OIL, GAS OR WATER RECORDS

CASING RECORD

FORMATION	CONTENT	FROM	TO	SIZE	PUT IN	PULLED OUT
	Surface Casing	0	1454	8-5/8	1454	None

Describe in detail the manner in which the well was plugged, indicating where the mud fluid was placed and the method or methods used in introducing it into the hole. If cement or other plugs were used, state the character of same and depth placed, from feet to feet for each plug set.

Hole filled with heavy 45 viscosity drilling mud from 5800' to 1400'. Cement plug placed from 1400' to 1340'. Heavy drilling mud from 1340' to 600'. Cement plug placed from 600' to 540'. Heavy drilling mud from 540' to 35'. Cement plug placed from 35' to 3'. Steel cap screwed onto 8-5/8" casing. Hole filled with surface dirt from 3' to surface.

RECEIVED
STATE CORPORATION COMMISSION

12-2-60 DEC 2 1960

CONSERVATION DIVISION
Wichita, Kansas

(If additional description is necessary, use BACK of this sheet)
Name of Plugging Contractor Holm Drilling Company
Address Box 7505, Tulsa, Oklahoma

STATE OF OKLAHOMA, COUNTY OF OKLAHOMA, ss.
H. M. Frost (employee of owner) or (owner or operator) of the above-described well, being first duly sworn on oath, says: That I have knowledge of the facts, statements, and matters herein contained and the log of the above-described well as filed and that the same are true and correct. So help me God.

(Signature) [Signature]
Box 552, Oklahoma City, Oklahoma
(Address)

SUBSCRIBED AND SWORN TO before me this 1st day of December, 1960

Carl E. Robinson
Notary Public.

My commission expires 10-12-62

