


WELL PLUGGING RECORD

Give All Information Completely
Make Required Affidavit
Mail or Deliver Report to
Conservation Division
State Corporation Commission
800 Bittling Building
Wichita, Kansas

Meade County. Sec. 18 Twp. 32 Rge. 29 (X) (W)
Location as "NE/CNW%SW%" or footage from lines C NW SE
Lease Owner Colorado Oil and Gas Corporation
Lease Name Gano Well No. 1
Office Address P. O. Box 999, Liberal, Kansas
Character of Well (completed as Oil, Gas or Dry Hole) Dry Hole
Date well completed 3-5 19 59
Application for plugging filed 19
Application for plugging approved 3-5 19 59
Plugging commenced 3-5 19 59
Plugging completed 3-5 19 59
Reason for abandonment of well or producing formation Dry Hole

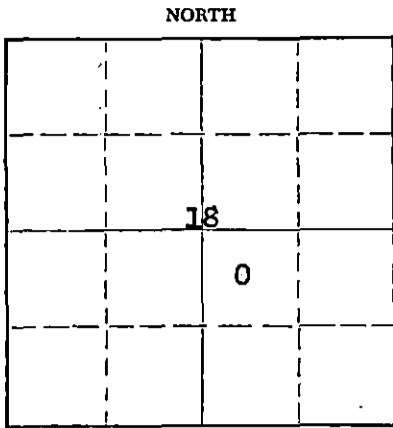

Locate well correctly on above
Section Plat

If a producing well is abandoned, date of last production 19
Was permission obtained from the Conservation Division or its agents before plugging was commenced? Yes

Name of Conservation Agent who supervised plugging of this well M. A. Rives
Producing formation None Depth to top Bottom Total Depth of Well 5820 Feet
Show depth and thickness of all water, oil and gas formations.

OIL, GAS OR WATER RECORDS

CASING RECORD

FORMATION	CONTENT	FROM	TO	SIZE	PUT IN	PULLED OUT
				8 5/8"	1623'	None

Describe in detail the manner in which the well was plugged, indicating where the mud fluid was placed and the method or methods used in introducing it into the hole. If cement or other plugs were used, state the character of same and depth placed, from feet to feet for each plug set.

Spotted 35 sx cement at 5628, filled hole with mud; set plug at 600', spotted 20 sx cement on top 600' to 545, filled hole with mud; set plug at 30' filled hole with cement to bottom of cellar, or 5' below ground level.

RECEIVED
STATE CORPORATION COMMISSION

MAR 13 1959

CONSERVATION DIVISION
Wichita, Kansas

(If additional description is necessary, use BACK of this sheet)

Name of Plugging Contractor Nye-Snell Drilling Company
Address Denver, Colorado

STATE OF Kansas, COUNTY OF Seward, ss.
A. J. Smith (employee of owner) or (owner or operator) of the above-described well, being first duly sworn on oath, says: That I have knowledge of the facts, statements, and matters herein contained and the log of the above-described well as filed and that the same are true and correct. So help me God.

(Signature) [Signature]

(Address)

SUBSCRIBED AND SWORN TO before me this 12th day of March, 19 59

William B. Claunch
Notary Public.

My commission expires 11-1-62

PLUGGING
FILE SEC 18 T 32 R 29w
BOOK PAGE 24 LINE 7

Company: COLORADO OIL AND GAS CORPORATION
 Farm: Gano No. 1-18

Sec. 18 T. 32 R. 29
 C NW SE

Total Depth. 5820
 Comm.

Comp. 3-5-59

County Meade
 Kansas

Elevation 2725 KB

Production D & A

sand & gravel	0 - 150
Red beds	900
Anhydrite	940
Red beds	1575
Anhydrite	1655
Red beds	2176
Anhydrite & salt	2625
Sh-anhy-dolo stringer	2710
Dolo-some sh stringers	2920
lm-some sh stringers	4220
Sh. lm	4410
Blk carb. sh.	4430
Blk sh & sh. lm.	4500
lm. scatt. chrt & sh.	5150
Oolitic & foss lm. + sh,	5360
Gy-blk sh-lm stringers	5670
Gy-blk grn sh-lm-sand stringers	5727
lm	5760
Gy-blk sh	5780
Sandy lm-lm	5820
TOTAL DEPTH	5820

TOPS:	
Lansing	4557
Marm	5175
Cher	5358
Morrow	5656
Miss	5727

Permission was given verbally by M. A. Rives, no application made.

RECEIVED
 STATE CORPORATION COMMISSION
 MAR 27 1959
 CONSERVATION DIVISION

PLUGGING
 FILE SEC. 18 T. 32 R. 29w
 BOOK PAGE 24 LINE -7