

15-119-10067-0000


STATE OF KANSAS  
STATE CORPORATION COMMISSION

WELL PLUGGING RECORD

Give All Information Completely  
Make Required Affidavit  
Mail or Deliver Report to:  
Conservation Division  
State Corporation Commission  
212 North Market, Insurance Bldg.  
Wichita, Kansas

Meade County. Sec. 19 Twp. 32S Rge. (E) 29 (W)

Location as "NE/CNW/SW" or footage from lines C SE SW  
Lease Owner Continental Oil Company  
Lease Name Earl Utz Well No. 1  
Office Address Drawer 367, Plainville, Kansas  
Character of Well (completed as Oil, Gas or Dry Hole) Gas  
Date well completed 3-17 19 61  
Application for plugging filed 2-19 19 63  
Application for plugging approved 2-20 19 63  
Plugging commenced 3-11 19 63  
Plugging completed 3-13 19 63  
Reason for abandonment of well or producing formation Depleted

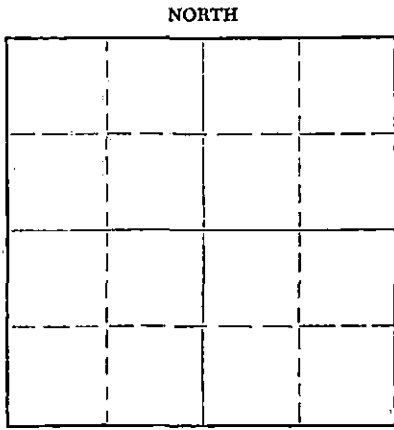

Locate well correctly on above  
Section Plat

If a producing well is abandoned, date of last production 1-31 19 63  
Was permission obtained from the Conservation Division or its agents before plugging was commenced? yes

Name of Conservation Agent who supervised plugging of this well Hugh E. Scott  
Producing formation Morrow Depth to top 5590 Bottom 5620 Total Depth of Well 5735 Feet  
Show depth and thickness of all water, oil and gas formations. PB 5703 Feet

OIL, GAS OR WATER RECORDS

CASING RECORD

FORMATION	CONTENT	FROM	TO	SIZE	PUT IN	PULLED OUT
<u>Morrow</u>	<u>Gas &amp; Water</u>	<u>5590</u>	<u>5620</u>	<u>8 5/8"</u>	<u>1675'</u>	<u>None</u>
				<u>4 1/2"</u>	<u>5783'</u>	<u>2800'</u>

Describe in detail the manner in which the well was plugged, indicating where the mud fluid was placed and the method or methods used in introducing it into the hole. If cement or other plugs were used, state the character of same and depth placed, from \_\_\_\_\_ feet to \_\_\_\_\_ feet for each plug set.

Pumped 35 sacks of cement down casing, plugging back to 4798'. Pulled 2800' of 4 1/2" casing. Mudded well from 4798' to 760'. Set rock bridge at 760' and dumped 35 sacks cement. Mudded to 55', set 10' of rock bridge and cemented to surface with 15 sacks. Surface pipe was cut off 36 inches below ground level and a metal cap was welded over the top. Filled cellar. P&A 3-13-63.

(If additional description is necessary, use BACK of this sheet)  
Name of Plugging Contractor Knight Casing Pulling Company  
Address Chase, Kansas

STATE OF Kansas COUNTY OF Rooks, ss.  
L. E. Powell (employee of owner) or (owner or operator) of the above-described well, being first duly sworn on oath, says: That I have knowledge of the facts, statements, and matters herein contained and the log of the above-described well as filed and that the same are true and correct. So help me God.

ARC  
State CRW File  
(Signature) L. E. Powell  
Drawer 367, Plainville, Kansas  
(Address)

SUBSCRIBED AND SWORN TO before me this 14th day of March, 19 63

My commission expires 12-2-65  
Kenneth J. Query Notary Public.

PROPERTY DESCRIPTION

OPERATOR: Continental Oil Company  





RECEIVED  
 STATE CORPORATION COMMISSION

FEB 20 1963

CONSERVATION DIVISION  
 Wichita, Kansas


We certify the above leg. is true and  
 correct to the best of our knowledge  
 and belief.

WALTER STEWART, INC.

*R.R. Myers*

H. R. ...

*Geological Society*

DWM

PJL

F:IE

