


Give All Information Completely
Make Required Affidavit
Mail or Deliver Report to:
Conservation Division
State Corporation Commission
211 No. Broadway
Wichita, Kansas

WELL PLUGGING RECORD

Meade County, Sec. 22 Twp. 32 Rge. (X) 29(W)

Location as "NE/CNW/SW" or footage from lines C NW NW
Lease Owner Kewanee Oil Company
Lease Name Gollither Well No. 1
Office Address Box 2093, Wichita, Kansas
Character of Well (completed as Oil, Gas or Dry Hole) Dry Hole
Date well completed April 30, 19 64
Application for plugging filed (Verbal) April 27, 19 64
Application for plugging approved April 27, 19 64
Plugging commenced April 29, 19 64
Plugging completed April 30, 19 64
Reason for abandonment of well or producing formation Dry Hole

NORTH

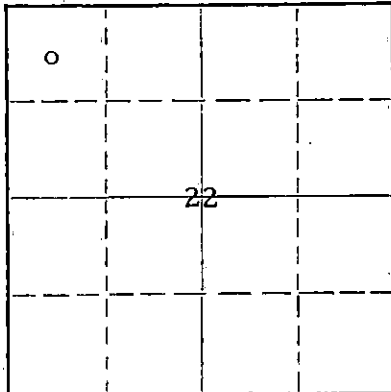

Locate well correctly on above
Section Plat

If a producing well is abandoned, date of last production 19
Was permission obtained from the Conservation Division or its agents before plugging was commenced? Yes

Name of Conservation Agent who supervised plugging of this well Hugh E. Scott
Producing formation Depth to top Bottom Total Depth of Well 6350 Feet
Show depth and thickness of all water, oil and gas formations.

OIL, GAS OR WATER RECORDS

CASING RECORD

FORMATION	CONTENT	FROM	TO	SIZE	PUT IN	PULLED OUT
Mississippi	Dry	0	1477	8-5/8"	1479'	0
		5698	6350		0	0

Describe in detail the manner in which the well was plugged, indicating where the mud fluid was placed and the method or methods used in introducing it into the hole. If cement or other plugs were used, state the character of same and depth placed, from feet to feet for each plug set.

6350' - 700' 10# Mud
700' - 580' 35 sacks Cement
580' - 45' 10# Mud
45' - Surface 15 sacks Cement

RECEIVED
STATE CORPORATION COMMISSION

MAY 13 1964

CONSERVATION DIVISION
Wichita, Kansas

(If additional description is necessary, use BACK of this sheet)

Name of Plugging Contractor Kewanee Oil Company
Address Box 2093, Wichita, Kansas

STATE OF Kansas, COUNTY OF Sedgwick, ss.
C. W. Mosier (employee of owner) or (owner) of the above-described well, being first duly sworn on oath, says: That I have knowledge of the facts, statements, and matters herein contained and the log of the above-described well as filed and that the same are true and correct. So help me God.

(Signature) [Signature]
Box 2093, Wichita, Kansas
(Address)

SUBSCRIBED AND SWORN TO before me this 11th day of May, 19 64

My commission expires August 2, 1965

Notary Public.

KEWANEE OIL COMPANY

Well Record & Sandology: Golliher #1-OJI Elevation: 2697' C. M.

Location: C NW NW (660' FNL & 655' FWL)
Section 22-32-29W, Meade County, Kansas

Drilling Commenced: April 6, 1964 Drilling Completed: April 28, 1964

Completion Date: April 30, 1964

TOTAL DEPTH: 6350 feet

Perforating Record: None

Treating Record: None

Initial Production: Dry

Formation Tops (Schlumberger)

Council Grove	3048	- 351
Heebner	4416	- 1719
Lansing	4578	- 1881
Marmaton	5180	- 2483
Morrow	5624	- 2927
Chester	5698	- 3001
Ste. Genevieve	5961	- 3264
St. Louis	6049	- 3352

Casing Record

Cemented 8-5/8 inch casing @ 1478.52' C. M. with
750 sacks pozmix, 2% gel and 200 sacks common
with 2% c. c. cement circulated.

Formation Record

0	Surface	4084	Lime & Shale
75	Sand & Clay	4189	Lime
100	Red Bed	4336	Shale & Lime
1460	Sand & Clay	4449	Shale
1473	Anhydrite	4505	Shale & Lime
2155	Shale	5147	Lime
2425	Shale & Shells	5209	Lime & Shale
2735	Lime & Shale	5262	Lime
3170	Lime	5489	Lime & Shale
3410	Lime & Shale	5697	Lime
3637	Lime & Chalk	5790	Lime & Shale
3845	Lime & Shale with Chalk Streaks	6350	Lime
3864	Lime	6350	Total Depth

RECEIVED
STATE CORPORATION COMMISSION

MAY 13 1964

CONSERVATION DIVISION
Wichita, Kansas