


STATE OF KANSAS  
STATE CORPORATION COMMISSION

WELL PLUGGING RECORD

Give All Information Completely  
Make Required Affidavit  
Mail or Deliver Report to  
Conservation Division  
State Corporation Comm.  
245 North Water  
Wichita, KS 67202

Morton County, Sec. 24 Twp. 33 Rge. 43 XE/W  
Location as "NE/CNW $\frac{1}{4}$ SW $\frac{1}{4}$ " or footage from lines  
554' FNL, 1874' FWL (NE NW)  
Lease Owner Cities Service Oil & Gas Corp.  
Lease Name Bernsen A Well No. 1  
Office Address 3545 N.W. 58th, Okla. City, OK 73112  
Character of Well (Completed as Oil, Gas or Dry Hole)  
Dry hole

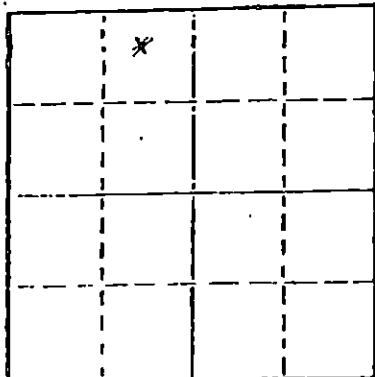

Date Well completed 8-12- 19 83  
Application for plugging filed 19  
Application for plugging approved 19  
Plugging commenced 8-11- 19 83  
Plugging completed 8-12- 19 83  
Reason for abandonment of well or producing formation  
Dry hole

If a producing well is abandoned, date of last production 19

Was permission obtained from the Conservation Division or its agents before plugging was commenced? Yes

Name of Conservation Agent who supervised plugging of this well  
Producing formation — Depth to top Bottom Total Depth of Well 5020'  
Show depth and thickness of all water, oil and gas formations.

OIL, GAS OR WATER RECORDS

CASING RECORD

FORMATION	CONTENT	FROM	TO	SIZE	PUT IN	PULLED OUT
				8-5/8"	1351'	None

Describe in detail the manner in which the well was plugged, indicating where the mud fluid was placed and the method or methods used in introducing it into the hold. If cement or other plugs were used, state the character of same and depth placed, from feet to feet for each plug set.

Ran OE drill pipe & spotted following OH cmt plugs:

35 sx 4750-4650'	Morrow
75 sx 3100-2880'	Topeka
50 sx 1380-1280'	In and out surf. csg.
40 sx 820-560	Middle surf. csg.
10 sx 40-3'	Top plug
15 sx rat hole	

(If additional description is necessary, use BACK of this sheet)

Name of Plugging Contractor Earl F. Wakefield, Inc. (drilling contractor)

STATE OF Oklahoma COUNTY OF Oklahoma, ss.

Verlin Meier (employee of owner) or (owner or operator) of the above-described well, being first duly sworn on oath, says: That I have knowledge of the facts, statements, and matters herein contained and the log of the above-described well as filed and that the same are true and correct. So help me God.

Verlin Meier Production Rgn. Mgr.

(Signature) Verlin Meier  
3545 N.W. 58th St., (Oklahoma City, OK 73112)  
(Address)

day of August, 19 83

Oliver E. Mues  
Notary Public.

(SUBSCRIBED AND SWORN TO before me this 23rd day of August, 1983)  
My commission expires July 12, 1984

RECEIVED  
STATE CORPORATION COMMISSION

SEP 1 1983 9-1-83

CONSERVATION DIVISION  
Wichita, Kansas