

15-129-00156-0000

STATE OF KANSAS  
STATE CORPORATION COMMISSION

Give All Information Completely  
Make Required Affidavit  
Mail or Deliver Report to:  
Conservation Division  
State Corporation Commission  
211 No. Broadway  
Wichita, Kansas

WELL PLUGGING RECORD

Morton County, Sec. 32 Twp. 33S Rge. (E) 43 (W)

Location as "NE/CNW/SW" or footage from lines NE/4 NW/4

Lease Owner Graham-Michaelis Drilling Company

Lease Name Ryman Well No. 1-32

Office Address 211 North Broadway, Wichita, Kansas 67202

Character of Well (completed as Oil, Gas or Dry Hole) Dry Hole

Date well completed June 15, 19 64

Application for plugging filed (verbal) June 15, 19 64

Application for plugging approved (verbal) June 15, 19 64


Plugging commenced June 15, 19 64

Plugging completed June 15, 19 64

Reason for abandonment of well or producing formation Dry Hole

If a producing well is abandoned, date of last production ----- 19

Was permission obtained from the Conservation Division or its agents before plugging was commenced? yes

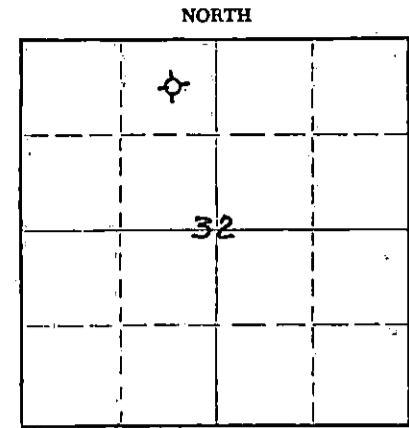

Locate well correctly on above Section Plat

Name of Conservation Agent who supervised plugging of this well Hugh Scott

Producing formation none Depth to top --- Bottom ---- Total Depth of Well 5003 Feet

Show depth and thickness of all water, oil and gas formations.

OIL, GAS OR WATER RECORDS

CASING RECORD

FORMATION	CONTENT	FROM	TO	SIZE	PUT IN	PULLED OUT
				8 5/8"	1372'	none

Describe in detail the manner in which the well was plugged, indicating where the mud fluid was placed and the method or methods used in introducing it into the hole. If cement or other plugs were used, state the character of same and depth placed, from feet to feet for each plug set.

Well was filled with heavy drilling mud. Set cement plug at 3300' with 175 sacks cement, filled with heavy drilling mud, set plug at 700' with 45 sacks cement. Filled with heavy drilling mud, cement plug at 40' with 15 sacks cement. Plug at top of surface casing.

RECEIVED  
STATE CORPORATION COMMISSION  
JUN 22 1964  
CONSERVATION DIVISION  
Wichita, Kansas

(If additional description is necessary, use BACK of this sheet)  
Name of Plugging Contractor Graham-Michaelis Drilling Company  
Address 211 North Broadway, Wichita, Kansas 67202

STATE OF Kansas, COUNTY OF Sedgwick, ss.  
John L. James (employee of owner) or (owner or operator) of the above-described well, being first duly sworn on oath, says: That I have knowledge of the facts, statements, and matters herein contained and the log of the above-described well as filed and that the same are true and correct. So help me God.

(Signature) John L. James Geologist  
211 North Broadway, Wichita, Kansas 67202  
(Address)

SUBSCRIBED AND SWORN TO before me this 17th day of June, 19 64.

Evelyn D. Evans  
Evelyn D. Evans Notary Public.

My commission expires December 12, 1966

RYMAN #1-32

## WELL RECORD:

## LOCATION:

C NE NW Section 32-33S-43W  
Morton County, Kansas

Commenced: 6-3-64  
Completed: 6-15-64  
(Rotary)

## CONTRACTOR:

Graham-Michaelis Drilling Co.  
Liberal Division  
P. O. Box 1294  
Liberal, Kansas

## CASING RECORD:

44 Joints 24# 8-5/8" Casing  
Cemented w/450 sx Lt. Wt.  
and w/200 sx Common

	<u>LOG</u>
Sand & Red Bed	0 - 810
Shale & Sand	810 - 2154
Shale	2154 - 2212
Lime & Shale	2212 - 2589
Lime	2589 - 2680
Lime & Shale	2680 - 3900
Shale	3900 - 4109
Lime & Shale	4109 - 4465
Shale	4465 - 4576
Lime & Shale	4576 - 4788
Shale	4788 - 4836
Lime & Shale	4836 - 4960
Lime	4960 - 5003

5003' - Total Rotary Depth

The undersigned, Graham-Michaelis Drilling Company, Liberal Division, certifies that the above log is a true and correct copy of the formations encountered in drilling the above mentioned well, as taken from the Daily Drilling Report.

GRAHAM-MICHAELIS DRILLING COMPANY  
LIBERAL DIVISION

By   
H. R. Michaelis

**RECEIVED**  
STATE CORPORATION COMMISSION

JUN 22 1964

CONSERVATION DIVISION  
Wichita, Kansas