

15-129-10348-0000

STATE OF KANSAS
STATE CORPORATION COMMISSION

Form CP-4

Give All Information Completely
Make Required Affidavit
Mail or Deliver Report to:
Conservation Division
State Corporation Commission
211 No. Broadway
Wichita, Kansas

WELL PLUGGING RECORD

Morton County, Sec. 33 Twp. 33 Rge. (E) 43 (W)

Location as "NE/CNW%SW%" or footage from lines SW SW NE

Lease Owner Colorado Oil & Gas Corporation

Lease Name Campbell Well No. 1-33

Office Address P.O. Box 158, Liberal, Kansas 67901

Character of Well (completed as Oil, Gas or Dry Hole) Gas

Date well completed 6-8-55 19

Application for plugging filed 8-9-65 19

Application for plugging approved 8-10-65 19


Plugging commenced 8-20-65 19

Plugging completed 8-20-65 19

Reason for abandonment of well or producing formation Not economical to produce

If a producing well is abandoned, date of last production 4-30-65 19

Was permission obtained from the Conservation Division or its agents before plugging was commenced? Yes

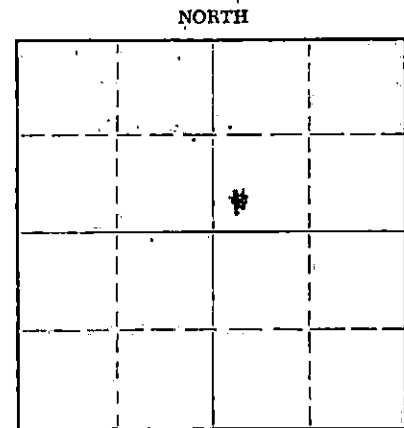

Locate well correctly on above Section Plat

Name of Conservation Agent who supervised plugging of this well A. Elvin

Producing formation Wab. Elmont & Topeka Depth to top 2851 Bottom 3104 Total Depth of Well 3193 Feet

Show depth and thickness of all water, oil and gas formations.

OIL, GAS OR WATER RECORDS

CASING RECORD

FORMATION	CONTENT	FROM	TO	SIZE	PUT IN	PULLED OUT
Wabaunsee	Gas	2851	2910	8-5/8"	617	None
Elmont	Gas	2947	2997	5-1/2"	3153	1029
Topeka	Gas	3027	3104			

Describe in detail the manner in which the well was plugged, indicating where the mud fluid was placed and the method or methods used in introducing it into the hole. If cement or other plugs were used, state the character of same and depth placed, ~~from~~ ^{at} 2700 feet ~~&~~ [&] at 600 feet for each plug set. Both cement

Ran 20 sack cement plug at 2700', shot Casing at 1029'.

Pulled Casing to 600' ran 35 sack cement plug. Filled

hole with heavy mud to 40', rock to 30' ran 10 sack cement

plug 30' to 3', cut off 8-5/8" at 3' below ground level and

welded cap on.

RECEIVED
STATE CORPORATION COMMISSION

9-3-65 SEP 3 1965

CONSERVATION DIVISION
Wichita, Kansas

(If additional description is necessary, use BACK of this sheet)

Name of Plugging Contractor Sargent's Casing Pulling Service

Address 121 West 9th, Liberal, Kansas 67901

STATE OF Kansas, COUNTY OF Seward, ss.

L.H. Walters (employee of owner) or (owner or operator) of the above-described well, being first duly sworn on oath, says: That I have knowledge of the facts, statements, and matters herein contained and the log of the above-described well as filed and that the same are true and correct. So help me God.

(Signature) L.H. Walters

(Address)

Subscribed and Sworn to before me this 2nd. day of September, 19 65

William B. Claunch
Notary Public.

My commission expires 11-1-66

15-129-10348-0000


WELL LOG BUREAU--KANSAS GEOLOGICAL SOCIETY
508 East Murdock, Wichita, Kansas

Company. COLORADO OIL & GAS CO.
Farm. Campbell No. 1-33

SEC. 33 T. 33 R. 43W
SW SW NE

Total Depth. 3195
Comm. 4-27-55 Comp. 5-8-55
Shot or Treated.
Contractor. HOLM DRILLING CO.
Issued. 6-25-55

County Morton
KANSAS

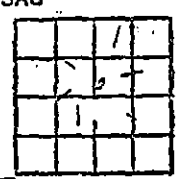

Elevation. 3643 DF

Production. 5,880,000 Gas

CASING:

8 5/8 612' w/ 400 sx cmt.
5 1/2 3153' w/ 150 sx cmt.

Figures indicate Bottom of Formations.

surface clay	35
sand, shale & shells	275
shale & shells	545
shale, shells & red bed	620
plug & cement	620
sand, shale & shells	745
shale & shells	940
gyp	980
shale & shells	1100
sand & shale	1265
shale & shells	1385
anhydrite	1410
shale & shells	2475
lime & shale	3195
Total Depth	

SCOUT TOPS:

Waubunsee	2697
Elmont	2911
Popeka	3029
Lecompton	3155

RECEIVED
STATE CORPORATION COMMISSION

OCT 1 1965

CONSERVATION DIVISION
Wichita, Kansas