


STATE OF KANSAS
STATE CORPORATION COMMISSION

Give All Information Completely
Make Required Affidavit
Mail or Deliver Report to:
Conservation Division
State Corporation Commission
212 No. Market
Wichita, Kansas

WELL PLUGGING RECORD

NORTH

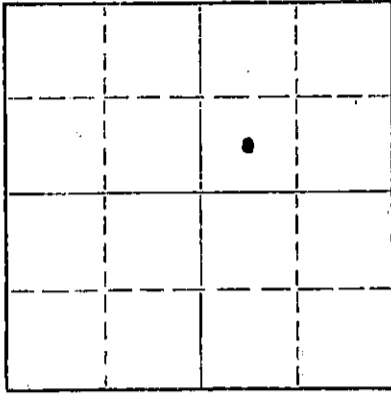

Locate well correctly on above
Section Plat

Barber County. Sec. 1 Twp. 34S Rge. 11 (E) W (W)
Location as "NE/CNW%SW%" or footage from lines SW NE
Lease Owner Mack Oil Company
Lease Name Swartz Well No. 1
Office Address
Character of Well (completed as Oil, Gas or Dry Hole) Dry Hole
Date well completed 12-1 19 68
Application for plugging filed 12-1 19 68
Application for plugging approved 12-1 19 68
Plugging commenced 12-1 19 68
Plugging completed 12-1 19 68
Reason for abandonment of well or producing formation Dry Hole

If a producing well is abandoned, date of last production 19
Was permission obtained from the Conservation Division or its agents before plugging was commenced? Yes

Name of Conservation Agent who supervised plugging of this well Ralph Waren
Producing formation Depth to top Bottom Total Depth of Well Feet
Show depth and thickness of all water, oil and gas formations.

OIL, GAS OR WATER RECORDS

CASING RECORD

| FORMATION | CONTENT | FROM | TO | SIZE | PUT IN | PULLED OUT |
|--------------|---------|------|-----|-------|--------|------------|
| Surface Pipe | | -0- | 314 | 8 5/8 | 314 | -0- |
| | | | | | | |
| | | | | | | |
| | | | | | | |
| | | | | | | |
| | | | | | | |
| | | | | | | |

Describe in detail the manner in which the well was plugged, indicating where the mud fluid was placed and the method or methods used in introducing it into the hole. If cement or other plugs were used, state the character of same and depth placed, from feet to feet for each plug set.


Filled hole with heavy mud
#1 plug @ 300' with 25 sks. cement.
#2 plug @ 40' with 10 sks. cement.
#3 plug in rathole with 2 sks. cement.

RECEIVED
STATE CORPORATION COMMISSION
DEC 5 1968
CONSERVATION DIVISION
Wichita, Kansas

(If additional description is necessary, use BACK of this sheet)
Name of Plugging Contractor Sweetman Drilling, Inc.
Address Box 645, Great Bend, Kansas 67530

STATE OF Kansas, COUNTY OF Barton, ss.
T. D. Sweetman (employee of owner) or (owner or operator) of the above-described well, being first duly sworn on oath, says: That I have knowledge of the facts, statements and matters herein contained and the log of the above-described well as filed and that the same are true and correct. So help me God.

(Signature) T. D. Sweetman
Box 645, Great Bend, Kansas 67530
(Address)

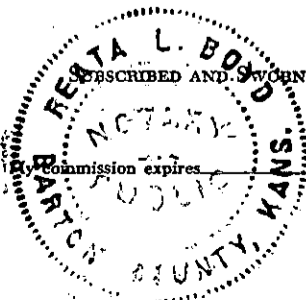

Subscribed and sworn to before me this 4th day of December, 1968
Heata L. Boyd
Notary Public.

WELL LOG
Swartz #1
SW NE 1-34S-11W
Barber County, Kansas

| FROM | TO | |
|------|------|-------------------------|
| 0 | 20 | Top soil |
| 20 | 346 | Red bed |
| 346 | 875 | Red bed and shale |
| 875 | 1265 | Shale |
| 1265 | 1615 | Shale, shells, and salt |
| 1615 | 2935 | Shale and lime |
| 2935 | 3360 | Lime |
| 3360 | 3500 | Lime and shale |
| 3500 | 3565 | Lime, shale and sand |
| 3565 | 3655 | Sand and shale |
| 3655 | 3824 | Lime |
| 3824 | 4005 | Lime and shale |
| 4005 | 4189 | Lime |
| 4189 | 4261 | Lime and shale |
| 4261 | 4335 | Lime |
| 4335 | 4420 | Lime and shale |
| 4420 | 4623 | Lime |
| 4623 | 4801 | Miss. lime |
| 4801 | 4880 | Shale and lime |
| 4880 | 5047 | Lime |
| 5047 | 5070 | Lime, shale and sand |
| 5070 | | Total Depth |

RECEIVED
STATE CORPORATION COMMISSION
DEC 5 1968
CONSERVATION DIVISION
Wichita, Kansas

STATE OF KANSAS

COUNTY OF BARTON ss.

T. D. Sweetman, President of Sweetman Drilling, Inc., being first duly sworn on oath says: That I have knowledge of the facts, statements and matters herein contained and the log of the above described well as filed and that the same are true and correct.

T. D. Sweetman
T. D. Sweetman

Subscribed and sworn before me this 4th day of December, 1968.

Kent L. Boyd
Notary Public Barton County

My Commission Expires 5-9-71.

