

STATE OF KANSAS
STATE CORPORATION COMMISSION


WELL PLUGGING RECORD

Give All Information Completely
Make Required Affidavit
Mail or Deliver Report to:
Conservation Division
State Corporation Commission
211 No. Broadway
Wichita, Kansas

Barber County. Sec. 3 Twp. 34 Rge. 11 (X) W (W)

Location as "NE/CNW/SW" or footage from lines SW NE NW
Lease Owner Petroleum, Inc.
Lease Name Finnup "D" Well No. 1
Office Address Route 2, Great Bend, Kansas
Character of Well (completed as Oil, Gas or Dry Hole) Dry hole
Date well completed November 7 19 57
Application for plugging filed August 12 19 58
Application for plugging approved August 14 19 58
Plugging commenced September 8 19 58
Plugging completed September 12 19 58
Reason for abandonment of well or producing formation No producible zones

NORTH

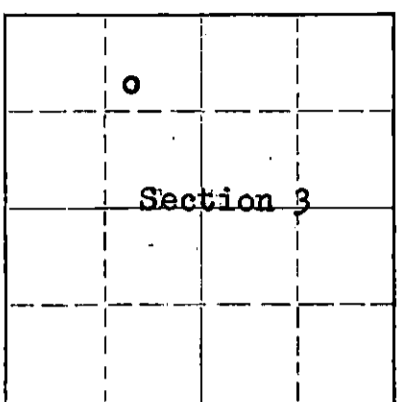

Locate well correctly on above
Section Plat

If a producing well is abandoned, date of last production None 19
Was permission obtained from the Conservation Division or its agents before plugging was commenced? Yes

Name of Conservation Agent who supervised plugging of this well W.L. Lackamp
Producing formation --- Depth to top --- Bottom --- Total Depth of Well 4540 Feet
Show depth and thickness of all water, oil and gas formations.

OIL, GAS OR WATER RECORDS

CASING RECORD

FORMATION	CONTENT	FROM	TO	SIZE	PUT IN	PULLED OUT
				8 5/8"	270'	None
				4 1/2"	4537'	3650'
<u>Mississippi</u>	<u>water & little gas</u>	<u>4490'</u>	<u>4510'</u>			

Describe in detail the manner in which the well was plugged, indicating where the mud fluid was placed and the method or methods used in introducing it into the hole. If cement or other plugs were used, state the character of same and depth placed, from _____ feet to _____ feet for each plug set.

(PLUGGED BACK TO 4529')

Filled hole with crushed rock from 4529' to 4480'. Placed 5 sacks cement on top of rock. Globe Oilwell Cementing Co. pumped in 50 sacks gel. Made solid rock bridge at 270' and placed 20 sacks cement on top of rock. Mud up to 35' and filled hole to base of well cellar with 10 sacks cement.

RECEIVED
STATE CORPORATION COMMISSION
SEP 16 1958

(If additional description is necessary, use BACK of this sheet)
Name of Plugging Contractor Morgan Well Plugging Service
Address 102 W. 18th Street, Hutchinson, Kansas

STATE OF Kansas COUNTY OF Barton, ss.
Don Searle (employee of owner) or Notary Public of the above-described well, being first duly sworn on oath, says: That I have knowledge of the facts, statements, and matters herein contained and the log of the above-described well as filed and that the same are true and correct. So help me God.
(Signature) Don Searle

SUBSCRIBED AND SWORN TO before me this 13th day of September, 19 58
Jul A. Brown
Notary Public.
My commission expires July 11, 1960

PLUGGING
FILE SEC 3 T. 34 R. 11W
BOOK PAGE 122 LINE 20

WELL LOG

COMPANY PETROLEUM, INCORPORATED

SEC. 3 T. 34S R. 11W

FARM FINNUP "D" NO. 1


LOC. SW, NE, NW

TOTAL DEPTH 4540'

COUNTY Barber Co., Kansas

COMM. October 10, 1957 COMP. October 22, 1957

CONTRACTOR GARVEY DRILLING COMPANY

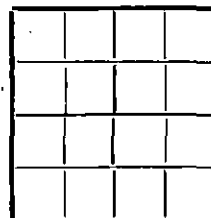

CASING 8 5/8" @ 270' W/250 sax.
4 1/2" @ 4537' W/100 sax.

ELEVATION 1349' DF

PRODUCTION Plugged & Abandoned

FIGURES INDICATE BOTTOM OF FORMATIONS

30	Surface soil & sand
270	Red bed
775	Red bed & shells
1585	Shale & shells
1780	Lime & shale
2100	Lime
2470	Shale & lime
2630	Shale
3355	Shale & lime
3470	Shale & sand
4134	Lime & shale
4316	Lime
4460	Shale & lime
4482	Lime
4525	Lime & chert
4540	Chert
4540	T. D.

RECEIVED
STATE CORPORATION COMMISSION
SEP 16 1958
CONSERVATION DIVISION
Kansas

PLUGGING
FILE SEC 3 T. 34 R. 11W
BOOK PAGE 122 LINE 20

State of KANSAS }
County of BARTON } ss:

I, Verne A. Morris of Garvey Drilling Co.

upon oath state that the above and foregoing is a true and correct copy of the log of the #1 Finnup "D" well

Subscribed and sworn to before me this 13th day of November 19 57

My Commission Expires: July 11, 1960

Ed J. Brawn
NOTARY PUBLIC