

STATE OF KANSAS
STATE CORPORATION COMMISSION

Form CP-4

Give All Information Completely
Make Required Affidavit
Mail or Deliver Report to:
Conservation Division
State Corporation Commission
212 No. Market
Wichita, Kansas 67202

WELL PLUGGING RECORD

Barber County, Sec. 6 Twp. 34 Rge. (E) 11(W)

Location as "NE/CNW/SW" or footage from lines C SE NE

Lease Owner Francis Oil & Gas, Inc.

Lease Name Newkirk Well No. 1

Office Address 513 E. 3rd, Ellinwood, Kansas 67526

Character of Well (completed as Oil, Gas or Dry Hole) oil

Date well completed _____ 19____

Application for plugging filed May 26 1970

Application for plugging approved _____ 19____


Plugging commenced June 2 1970

Plugging completed June 5 1970

Reason for abandonment of well or producing formation depleted

If a producing well is abandoned, date of last production _____ 19____

Was permission obtained from the Conservation Division or its agents before plugging was commenced? yes

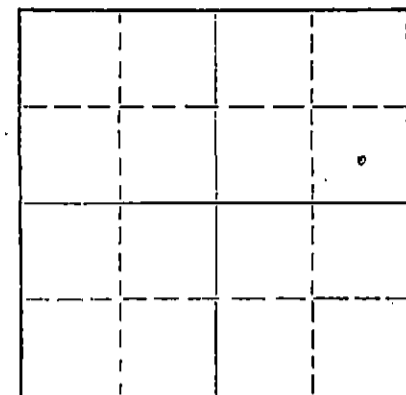

Locate well correctly on above Section Plat

Name of Conservation Agent who supervised plugging of this well: G. R. Biberstein

Producing formation _____ Depth to top _____ Bottom _____ Total Depth of Well 4630 Feet

Show depth and thickness of all water, oil and gas formations.

OIL, GAS OR WATER RECORDS

CASING RECORD

| FORMATION | CONTENT | FROM | TO | SIZE | PUT IN | PULLED OUT |
|------------------------------|---------|------|-------|--------|--------|------------|
| RECEIVED | | 0 | 220' | 8 5/8" | 220' | none |
| STATE CORPORATION COMMISSION | | 0 | 4616' | 5 1/2" | 4616' | 3490.47 |
| JUN 10 1970 | | | | | | |
| CONSERVATION DIVISION | | | | | | |
| Wichita, Kansas | | | | | | |

Describe in detail the manner in which the well was plugged, indicating where the mud fluid was placed and the method or methods used in introducing it into the hole. If cement or other plugs were used, state the character of same and depth placed, from _____ feet to _____ feet for each plug set.

Pushed plug to 3600' and dumped 5 sacks of cement.

Squeezed well with 100 sacks of cement and 15 sacks of gel mud.

Name of Plugging Contractor PIPE PULLERS, INC.
Address Box 486, Ellinwood, Kansas

STATE OF Kansas, COUNTY OF Barton, ss.
Evelyn Roth (employee of owner) or (owner or operator) of the above-described well, being first duly sworn on oath, says: That I have knowledge of the facts, statements, and matters herein contained and the log of the above-described well as filed and that the same are true and correct. So help me God.

(Signature) Evelyn Roth
Ellinwood, Kansas (Address)

SUBSCRIBED AND SWORN TO before me this 9th day of June, 19 70

My commission expires July 7, 1972

[Signature] Notary Public.

COMPANY Francis Oil & Gas, Inc.

FARM Newkirk NO. 1

SEC. 6 T. 34 R. 11
LOC. 100 ft. South &
50 ft. East of
SE 1/4 NE 1/4

COUNTY Barber

TOTAL DEPTH 4630'

COMM. 6/6/57


COMP. 6/22/57

BHPT OR TREATED

CONTRACTOR Armer, Inc.

ISSUED

KANSAS

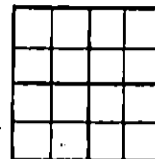

CASING

| | |
|----|---------|
| 20 | 10 |
| 15 | 8 220' |
| 12 | 6 |
| 13 | 5 4630' |

ELEVATION 1421 DF
1424 KB

PRODUCTION

FIGURES INDICATE BOTTOM OF FORMATIONS

| | |
|------------------------------|------|
| Red Bed and Gup | 220 |
| Red Bed and Gup | 400 |
| Shale and Shells and Red Bed | 1050 |
| Shale and Shells | 1525 |
| Lime and Shale | 3000 |
| Lime | 3310 |
| Shale and Lime | 3645 |
| Shale | 3755 |
| Shale and Lime | 3995 |
| Lime | 4060 |
| Lime and Shale | 4235 |
| Lime | 4397 |
| Lime and Shale | 4435 |
| Lime | 4545 |
| Lime and Chert | 4585 |
| Chert | 4596 |
| Chert and Lime | 4622 |
| Cherty Lime | 4630 |

RECEIVED
STATE CORPORATION COMMISSION
MAY 27 1970
CONSERVATION DIVISION
Wichita, Kansas

FORMATION TOPS:

LANSING 3847'
MISSISSIPPI 4542'

I hereby certify that this is a true and correct log of the above described well as shown by the drilling reports.

ARMER INC.

By C.P. Spruill

STATE OF KANSAS
COUNTY OF SEDGWICK

Subscribed and sworn to before me, a notary public, in and for said County and State this 27th day of June, 1957.

Rose Fusco
Notary Public

My Commission expires February 13, 1960.