


STATE OF KANSAS
STATE CORPORATION COMMISSION
CONSERVATION DIVISION
P. O. BOX 17027
WICHITA, KANSAS 67217

FORM CP-4

WELL PLUGGING RECORD

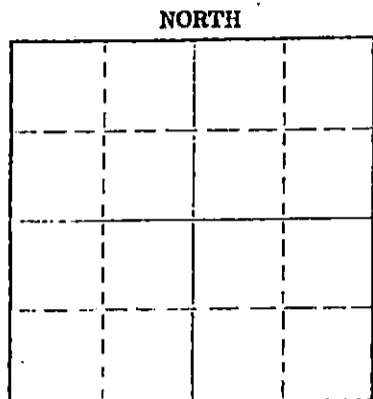

Locate well correctly on above Section Plot

Barber County, Sec 6 Twp 34S Rge 11 X2X (W)
Location as "NE/CNW&SW" or footage from lines 5/2 NE NE
Lease Owner Edmiston Oil Co.
Lease Name Bayliffe Well No. 3
Office Address 405 First National Bank Bldg., Wichita, Kansas
Character of Well (completed as Oil, Gas or Dry Hole) dry hole
Date well completed July 19 19 75
Application for plugging filed July 19 19 75
Application for plugging approved July 19 19 75
Plugging commenced July 19 19 75
Plugging completed July 19 19 75
Reason for abandonment of well or producing formation dry hole

If a producing well is abandoned, date of last production _____ 19 ____
Was permission obtained from the Conservation Division or its agents before plugging was commenced? Yes, verbally

Name of Conservation Agent who supervised plugging of this well G. R. Biberstein
Producing formation _____ Depth to top _____ Bottom _____ Total Depth of Well 4693 Feet
Show depth and thickness of all water, oil and gas formations.

OIL, GAS OR WATER RECORDS

CASING RECORD

FORMATION	CONTENT	FROM	TO	SIZE	PUT IN	PULLED OUT
				8-5/8	284	

Describe in detail the manner in which the well was plugged, indicating where the mud fluid was placed and the method or methods used in introducing it into the hole. If cement or other plugs were used, state the character of same and depth placed, from _____ feet to _____ feet for each plug set.

1st plug at 250' with 35 sacks
2nd plug at 40' with 15 sacks, 2 sacks in rathole

RECEIVED
STATE CORPORATION COMMISSION
JUL 23 1975
CONSERVATION DIVISION
Wichita, Kansas

(If additional description is necessary, use BACK of this sheet)
Name of Plugging Contractor Union Drilling Co., Inc.
Address 505 Union Center, Wichita, Kansas 67202

STATE OF KANSAS COUNTY OF SEDGWICK SS.
R. D. Messinger

(employee of owner) or (owner or operator) of the above-described well, being first duly sworn on oath, says: That I have knowledge of the facts, statements, and matters herein contained and the log of the above-described well as filed and that the same are true and correct. So help me God.

(Signature) R. D. Messinger
505 Union Center, Wichita, Kansas

21st day of July 19 75

July 29, 1978

Donna F. Brown
Donna F. Brown Notary Public.



JUL 22 1975

CONTRACTOR'S WELL LOG

OPERATOR:	Edmiston Oil Co.
CONTRACTOR:	Union Drilling Co., Inc.
WELL NAME:	#3 Bayliffe
LOCATION:	S/2 NE NE Section 6-34S-11W Barber County, Kansas
COMMENCED:	July 2, 1975
COMPLETED:	July 19, 1975

0	1270	Shale	8-5/8" casing set at 284' w/200 sacks
1270	1894	Shale & Lime	
1894	2657	Lime & Shale	
2657	2850	Shale & Lime	
2850	4324	Lime and shale	
4324	4424	Lime	
4424	4430	Lime and shale	
4430	4470	Lime	
4470	4510	Lime and shale	
4510	4580	Lime	
4580	4608	Lime	
4608	4660	Lime and shale	
4660	4693	Lime	
4693	T. D.		

We certify that the above and foregoing is a true and correct copy of the log on the #3 Bayliffe, S/2 NE NE Section 6-34S-11W, Barber County, Kansas.

UNION DRILLING CO., INC.

R. D. Messinger
R. D. Messinger

Subscribed and sworn to before me, a Notary Public, in and for the aforesaid county and state as of this 21st day of July, 1975.

Donna F. Brown
Donna F. Brown, Notary Public

My commission expires:

July 29, 1978



RECEIVED
STATE CORPORATION COMMISSION

JUL 23 1975

CONSERVATION DIVISION
Wichita, Kansas