


15-007-00553-0000

STATE OF KANSAS
STATE CORPORATION COMMISSION

Give All Information Completely
Make Required Affidavit
Mail or Deliver Report to:
Conservation Division
State Corporation Commission
800 Bittling Building
Wichita, Kansas

WELL PLUGGING RECORD

NORTH

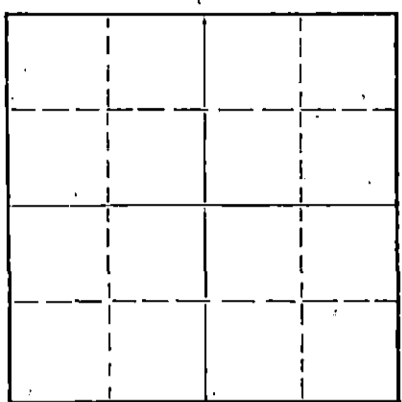

Locate well correctly on above
Section Plat

Barber County, Sec. 5 Twp. 34S Rge. 11 (E) 11 (W)
Location as "NE/CNW/SW" or footage from lines SE SE NE/4
Lease Owner M. B. Armer
Lease Name Groendyke Well No. 1
Office Address 710 Petroleum Bldg., Wichita, Kansas
Character of Well (completed as Oil, Gas or Dry Hole) Dry Hole
Date well completed Oct. 4, 19 54
Application for plugging filed " " 19 "
Application for plugging approved " " 19 "
Plugging commenced " " 19 "
Plugging completed " " 19 "
Reason for abandonment of well or producing formation Dry

If a producing well is abandoned, date of last production 19
Was permission obtained from the Conservation Division or its agents before plugging was commenced? Yes

Name of Conservation Agent who supervised plugging of this well M. A. Rives
Producing formation Depth to top Bottom Total Depth of Well 4650 Feet
Show depth and thickness of all water, oil and gas formations.

OIL, GAS OR WATER RECORDS

CASING RECORD

FORMATION	CONTENT	FROM	TO	SIZE	PUT IN	PULLED OUT
				8 5/8"	234'	None

Describe in detail the manner in which the well was plugged, indicating where the mud fluid was placed and the method or methods used in introducing it into the hole. If cement or other plugs were used, state the character of same and depth placed, from feet to feet for each plug set.

Filled hole with heavy Rotary Mud to 230 ft.
set plug and 20 sacks cement through drill pipe.
Mudded to 40 ft., set plug and 10 sacks cement
at the surface.

(If additional description is necessary, use BACK of this sheet)

Name of Plugging Contractor M. B. Armer
Address Wichita, Kansas

STATE OF KANSAS, COUNTY OF SEDGWICK, ss.
L. C. Sponenberg (employee of owner) or (conservation officer) of the above-described well, being first duly sworn on oath, says: That I have knowledge of the facts, statements, and matters herein contained and the log of the above-described well as filed and that the same are true and correct. So help me God.

(Signature) L. C. Sponenberg
(Address)

SUBSCRIBED AND SWORN TO before me this 8th day of October, 19 54

My commission expires February 13, 1956.

RECEIVED
STATE CORPORATION COMMISSION
OCT - 9 1954
PLUGGING
FILE SEC 5 T 34 R 111
BOOK PAGE 69 LINE 34
Notary Public.

15-007-00553-0000
KANSAS GEOLOGICAL SOCIETY
 KANSAS WELL LOG BUREAU - KANSAS WELL SAMPLE BUREAU
 KANSAS GEOLOGICAL SOCIETY BUILDING
 508 EAST MURDOCK - WICHITA, KANSAS

COMPANY **M. B. Armer**

SEC. **5** T. **34S.** R. **11W**
 LOC. **SE SE NE**

FARM **Groendyke** NO. **1**

TOTAL DEPTH **4650'**

COUNTY **Barber**

COMM. **9/18/54**


COMP. **10/4/54**

KANSAS

SHOT OR TREATED

CONTRACTOR **M. B. Armer**

ISSUED

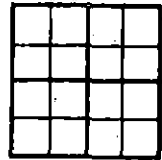

CASING

20	10	
15	8	234'
12	6	
13	5	

ELEVATION **1392 K.B.**

PRODUCTION **D & A**

FIGURES INDICATE BOTTOM OF FORMATIONS

Surface Clay	25
Red Bed	475
Shale & Shells	560
Sand	630
Red Bed	760
Shale & Shells	1240
Lime - Anhydrite	1265
Shale, Lime & Salt	1480
Shale & Lime	1590
Lime	1880
Shale & Lime	2200
Broken Lime	2395
Shale & Lime	2690
Shale - Streaks of Lime	2850
Shale & Lime	3055
Broken Lime	3165
Hard Sandy Lime	3225
Shale & Lime	3315
Broken Lime	3378
Shale & Lime	3480
Shale & Sand	3580
Shale & Lime	3832
Sand	3869
Lime	3895
Broken Lime	3940
Lime	4020
Sand & Lime	4140
Shale & Lime	4162
Lime	4530
Chert	4550
Lime	4595
Cherty Lime	4630
Lime	4647
Chert	4650

FORMATION TOPS (K.B. Meas.)

ELGIN	3471
HEEBNER	3610
LANSING	3825
KANSAS CITY	4138
MISSISSIPPI	4523

I hereby certify that this is a true and correct log of the above described well as shown by the drilling reports.

M. B. ARMER

STATE OF KANSAS
 COUNTY OF SEDGWICK

SS:

RECEIVED
 OCT 10 1954

By *[Signature]*
PLUGGING
 SEC **5** T. **34S.** R. **11W**
 BOOK **69** PAGE **34**

Subscribed and sworn to before me, a notary public, in and for said County and State this 8th day of October, 1954.

My Commission expires February 13, 1956.

[Signature]
 Notary Public