


STATE OF KANSAS
STATE CORPORATION COMMISSION
CONSERVATION DIVISION
P. O. BOX 17027
WICHITA, KANSAS 67217

FORM CP-4

WELL PLUGGING RECORD

Barber County. Sec. 11 Twp. 35S Rge. 13W (E) (W)
Location as "NE/CNW&SW" or footage from lines. C SE NW
Lease Owner. Okmar Oil Co.
Lease Name Achenbach "A" Well No. 3
Office Address 970 Fourth Financial Center, Wichita, Kansas
Character of Well (completed as Oil, Gas or Dry Hole) Dry Hole
Date well completed December 3 19 75
Application for plugging filed December 3 19 75
Application for plugging approved December 3 19 75
Plugging commenced December 3 19 75
Plugging completed December 3 19 75
Reason for abandonment of well or producing formation dry hole

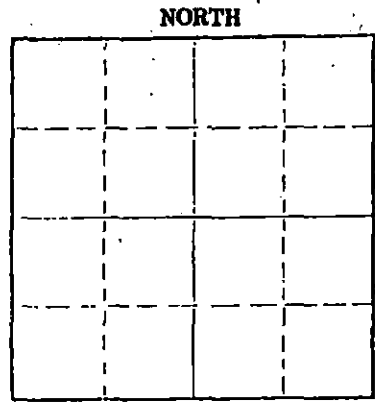

Locate well correctly on above Section Plat

If a producing well is abandoned, date of last production 19
Was permission obtained from the Conservation Division or its agents before plugging was commenced? Yes, verbally

Name of Conservation Agent who supervised plugging of this well G. R. Biberstein
Producing formation _____ Depth to top _____ Bottom _____ Total Depth of Well 4937 Feet
Show depth and thickness of all water, oil and gas formations.

OIL, GAS OR WATER RECORDS

CASING RECORD

FORMATION	CONTENT	FROM	TO	SIZE	PUT IN	PULLED OUT
				8-5/8"	251	

Describe in detail the manner in which the well was plugged, indicating where the mud fluid was placed and the method or methods used in introducing it into the hole. If cement or other plugs were used, state the character of same and depth placed, from _____ feet to _____ feet for each plug set.

1st plug set at 250' with 35 sacks
2nd plug set at 40' with 15 sacks, 2 sacks in rathole

(If additional description is necessary, use BACK of this sheet)
Name of Plugging Contractor Unbn Drilling Co., Inc.
Address 505 Union Center, Wichita, Kansas 67202

STATE OF KANSAS COUNTY OF SEDGWICK
R. D. Messinger (employee of owner) or (owner or operator) of the above-described well, being first duly sworn on oath, says: That I have knowledge of the facts, statements, and matters herein contained and the log of the above-described well as filed and that the same are true and correct. So help me God.

(Signature) R. D. Messinger
505 Union Center, Wichita, Kansas (Address)

SUBSCRIBED AND SWORN TO before me this 5th day of December 19 75

My commission expires July 29, 1978
Donna F. Brown Notary Public

RECEIVED
STATE CORPORATION COMMISSION
JAN 7 1976
CONSERVATION DIVISION
Wichita, Kansas

CONTRACTOR'S WELL LOG

OPERATOR:	Okmar Oil Co.
CONTRACTOR:	Union Drilling Co., Inc.
WELL NAME:	Achenbach "A" #3
LOCATION:	C SE NW Section 11-35S-13W Barber County, Kansas
COMMENCED:	November 19, 1975
COMPLETED:	December 3, 1975

0	215	Sand and shale	
215	1925	Shale	8-5/8" casing set at 251 with 200 sacks
1925	3575	Lime and shale	
3575	3754	Shale and lime	
3754	4415	Lime and shale	
4415	4457	Lime	
4457	4599	Lime and shale	
4599	4649	Lime	
4649	4876	Lime and shale	
4876	4937	Lime	
4937		T. D.	

We certify that the above and foregoing is a true and correct copy of the log on the Achenbach "A" #3, C SE NW Section 11-35S-13W, Barber County, Kansas.

UNION DRILLING CO., INC.

R. D. Messinger
R. D. Messinger

STATE OF KANSAS)
) SS
 COUNTY OF SEDGWICK)

Subscribed and sworn to before me, a Notary Public in and for the aforesaid county and state as of this 5th day of December, 1975.

Donna F. Brown
Donna F. Brown - Notary Public

My commission expires:

July 29, 1978

RECEIVED
 STATE CORPORATION COMMISSION
 JAN 7 1976
 CONSERVATION DIVISION
 Wichita, Kansas