

STATE OF KANSAS  
STATE CORPORATION COMMISSION

Form CP-4

Give All Information Completely  
Make Required Affidavit  
Mail or Deliver Report to:  
Conservation Division  
State Corporation Commission  
212 No. Market  
Wichita, Kansas 67202

WELL PLUGGING RECORD

Kingman County, Sec. 17 Twp. 30 Rge. 6 (E) W (W)

Location as "NE/CNW/SW" or footage from lines C SW/4 SE/4

Lease Owner Eli Wilkonson

Lease Name Riggs Well No. 1

Office Address 415 Philtower Bldg. Tulsa, Okla.

Character of Well (completed as Oil, Gas or Dry Hole) oil well

Date well completed 11-17-66 19

Application for plugging filed 7-6-70 19

Application for plugging approved 7-8-70 19


Plugging commenced 7-17-70 19

Plugging completed 7-23-70 19

Reason for abandonment of well or producing formation depleted

If a producing well is abandoned, date of last production 19

Was permission obtained from the Conservation Division or its agents before plugging was commenced? yes

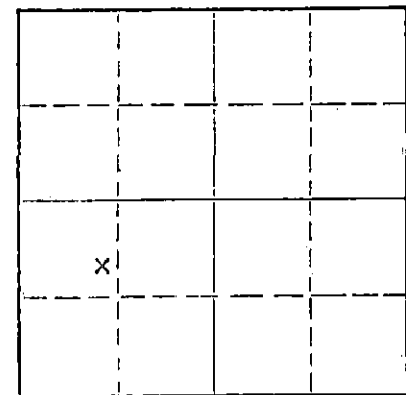

Locate well correctly on above Section Plat

Name of Conservation Agent who supervised plugging of this well G.R. Barbstine

Producing formation Depth to top Bottom Total Depth of Well 4186 Feet

Show depth and thickness of all water, oil and gas formations.

OIL, GAS OR WATER RECORDS

CASING RECORD

FORMATION	CONTENT	FROM	TO	SIZE	PUT IN	PULLED OUT
				8 5/8	260'	none
				4 1/2"	4186'	2986.50'

Describe in detail the manner in which the well was plugged, indicating where the mud fluid was placed and the method or methods used in introducing it into the hole. If cement or other plugs were used, state the character of same and depth placed, from feet to feet for each plug set.

Set a 10' rock bridge at 4100', mix and dump 3 sacks cement.

Set 10' rock bridge from 240' to 230', dumped 4 yards of ready mix to surface.

RECEIVED  
STATE CORPORATION COMMISSION  
AUG 6 1970  
CONSERVATION DIVISION  
Wichita, Kansas

(If additional description is necessary, use BACK of this sheet)  
Name of Plugging Contractor Flint Engineering and Const. Co.  
Address 2375 W. Central El Dorado, Kansas

STATE OF Kansas, COUNTY OF Butler, ss.

(employee of owner) or (owner or operator) of the above-described well, being first duly sworn on oath, says: That I have knowledge of the facts, statements, and matters herein contained and the log of the above-described well as filed and that the same are true and correct. So help me God.

(Signature) Richard C. Houseman

(Address)

Subscribed and sworn to before me this 30 day of July, 19 70

Richard Davis

Notary Public.

Sept. 19, 1971



15-095-30261-0000  
**KANSAS GEOLOGICAL SOCIETY**  
 KANSAS WELL LOG BUREAU - KANSAS WELL SAMPLE BUREAU  
 KANSAS GEOLOGICAL SOCIETY BUILDING  
 508 EAST MURDOCK - WICHITA, KANSAS

COPY

COMPANY SHAW HUGHES

SEC. 17 T. 30 R. 6W  
 LOC. C SW SE

FARM Riggs

NO. 1

TOTAL DEPTH 4621'

COUNTY Kingman


COMM. 5-27-66

COMP. 11-17-66

SHOT OR TREATED

CONTRACTOR Garvey Drigg.

ISSUED 3-2-68

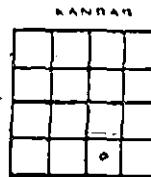

CASING

20	10	
15	B 5/8	260' w/200 sx cem.
12	6	
13	K 4 1/2	4186' w/125 sx cem.

ELEVATION 1421' KB

PRODUCTION Est Pmp 13  
 BO & 120 MCF/GD (MISS  
 4094-98)

FIGURES INDICATE BOTTOM OF FORMATIONS

COMPLETE DRILLERS LOG NOT AVAILABLE.

TOPS: SCOUT	
Topoka	2540
Ileebnor	3016
Douglas	3101
Kansas City	3623 3523
B/Kansas City	3770
Mississippi	4079
Kinderhook	4353
Misener	4471
Simpson	4477
Arbuckle	4598

RECEIVED  
 STATE CORPORATION COMMISSION  
 JUL 8 1970  
 CONSERVATION DIVISION  
 Wichita, Kansas