


STATE OF KANSAS
STATE CORPORATION COMMISSION

WELL PLUGGING RECORD

Give All Information Completely
Make Required Affidavit
Mail or Deliver Report to
Conservation Division
State Corporation Comm.
245 North Water
Wichita, KS 67202

Kingman County, Sec. 17 Twp. 30S Rge. 6 ~~NE~~/W
Location as "NE/CNW $\frac{1}{4}$ SW $\frac{1}{4}$ " or footage from lines
C-NW-NE
Lease Owner J. M. Huber Corporation
Lease Name Messenger Well No. 1-17
Office Address 2450 Liberty Tower, OK City, OK 73102
Character of Well (Completed as Oil, Gas or Dry Hole)

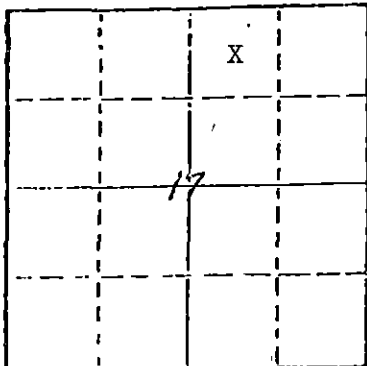

Locate well correctly on above
Section Plot

Dry Hole
Date Well completed As Dry Hole 11-13- 1980
Application for plugging filed None 19
Application for plugging approved None 19
Plugging commenced 11-13 1980
Plugging completed 11-13 1980
Reason for abandonment of well or producing formation

Dry Hole
If a producing well is abandoned, date of last production
19

Was permission obtained from the Conservation Division or
its agents before plugging was commenced? Yes 11-13-80

Name of Conservation Agent who supervised plugging of this well D. Rankin
Producing formation None Depth to top - Bottom - Total Depth of Well 4535'
Show depth and thickness of all water, oil and gas formations.

OIL, GAS OR WATER RECORDS

CASING RECORD

FORMATION	CONTENT	FROM	TO	SIZE	PUT IN	PULLED OUT
Surface Formations *	Water			13"	51'	-0-
Surface Formations *	Water			9-5/8"	333.6'	-0-

Describe in detail the manner in which the well was plugged, indicating where the mud fluid
was placed and the method or methods used in introducing it into the hold. If cement or other
plugs were used, state the character of same and depth placed, from feet to
feet for each plug set.

Commenced plugging operations with hole filled w/9.6#/gal mud. Spot 30 sx common cement
plug from 300' to 360' through drillpipe. Spot 15 sx common cement plug through drill-
pipe 10' to 40'. Spot 5 sx common cement plug in rat hole. Cut off casing 3' below
ground level and weld on steel cap.

RECEIVED
DEC - 5 1980
WICHITA, KANSAS
CONSERVATION DIVISION

(If additional description is necessary, use BACK of this sheet)

Name of Plugging Contractor Gabbert-Jones (Rig), Halliburton (Cement).

STATE OF Oklahoma COUNTY OF Oklahoma, ss:
Paul R. Seelye (employee of owner) or ~~(owner)~~

of the above-described well, being first duly sworn on oath, says: That I have knowledge of
the facts, statements, and matters herein contained and the log of the above-described well
as filed and that the same are true and correct. So help me God.

(Signature) Paul R. Seelye
2450 Liberty Tower, Oklahoma City, OK 73102
(Address)

SUBSCRIBED AND SWORN TO before me this 1st day of December, 1980

Luc Sprack
Notary Public.

My commission expires Jan. 18, 1984

* Chikaskia River Fluvial Deposits.