

STATE OF KANSAS
STATE CORPORATION COMMISSION

Give All Information Completely
Make Required Affidavit
Mail or Deliver Report to:
Conservation Division
State Corporation Commission
800 Birling Building
Wichita, Kansas

WELL PLUGGING RECORD

Seward

County. Sec. 14 Twp. 32 Rge. 34W (E) (W)

Location as "NE/CNW/SW" or footage from lines 100'S & 100'W of Center Section

Lease Owner American Gas Production Company

Lease Name Stoner #1

Well No.

Office Address Bartlesville, Oklahoma

Character of Well (completed as Oil, Gas or Dry Hole) Completed as Gas Well

Date well completed 7-19-48 19

Application for plugging filed 6-13-1952 19

Application for plugging approved 6-14-1952 19

Plugging commenced 10-15-1952 19

Plugging completed 10-17-1952 19

Reason for abandonment of well or producing formation Mechanical Difficulties,
Unable to shut off water

If a producing well is abandoned, date of last production August 5, 1952 19

Was permission obtained from the Conservation Division or its agents before plugging was commenced? Yes

Name of Conservation Agent who supervised plugging of this well R. J. Phillippe

Producing formation _____ Depth to top _____ Bottom _____ Total Depth of Well 2775 Feet

Show depth and thickness of all water, oil and gas formations.

OIL, GAS OR WATER RECORDS

CASING RECORD

FORMATION	CONTENT	FROM	TO	SIZE	PUT IN	PULLED OUT
				8-5/8	640	None
				5 1/2"	2796	"

Describe in detail the manner in which the well was plugged, indicating where the mud fluid was placed and the method or methods used in introducing it into the hole. If cement or other plugs were used, state the character of same and depth placed, from _____ feet to _____ feet for each plug set.

Rig up Unit

Ran Baker C.I. retainer on tubing to 2500'

Squeezed with 200 sacks of cement to 3000#

Cement from 2500 to 2260'

Hvy mud from 2260' to 500'

Cement from 460' to 500'

Mud from 460' to 50'

Cement from 50' to 5' of surface at which point the 8-5/8" casing was cut off and a steel cap was welded on the 8-5/8" casing

(If additional description is necessary, use BACK of this sheet)

Name of Plugging Contractor Nuss Well Servicing Company

Address Liberal, Kansas

STATE OF Kansas, COUNTY OF Seward, ss.

_____, (employee of owner) or (owner or operator) of the above-described well, being first duly sworn on oath, says: That I have knowledge of the facts, statements, and matters herein contained and the log of the above-described well as filed and that the same are true and correct. So help me God.

(Signature) H.V. Anderson

Box 70, Liberal, Kansas

(Address)


SUBSCRIBED AND SWORN TO before me this 18th day of October, 1952

My commission expires 5-23-1953

24-2678-5 2-52-20M

J. Maloney

Notary Public.

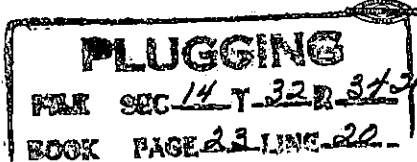

GIVED
COMMISSION

1952 10-20-52
ON DIVISION
Kansas