

STATE OF KANSAS  
STATE CORPORATION COMMISSION

WELL PLUGGING RECORD

Give All Information Completely  
Make Required Affidavit  
Mail or Deliver Report to  
Conservation Division  
State Corporation Comm.  
245 North Water  
Wichita, KS 67202

Seward County, Sec. 16 Twp. 32S Rge. 34 ~~EX~~W  
Location as "NE/CNW $\frac{1}{4}$ SW $\frac{1}{4}$ " or footage from lines  
300' FWL, 100' FSL NE/4

Lease Owner Cities Service Company  
Lease Name Kapp A Well No. 2


Office Address 3545 N.W. 58th Street - Okla. City, OK 73112

Character of Well (~~Completed~~ ~~OK~~ ~~Gas~~ ~~OK~~ Dry Hole)  
Dry Hole

Date Well completed May 31 1977  
Application for plugging filed May 1 1980  
Application for plugging approved May 6 1980  
Plugging commenced May 21 1980  
Plugging completed May 31 1980

Reason for abandonment of well or producing formation  
Was drilled and showed dry hole  
If a producing well is abandoned, date of last production  
Never Produced 19

Was permission obtained from the Conservation Division or  
its agents before plugging was commenced? Yes

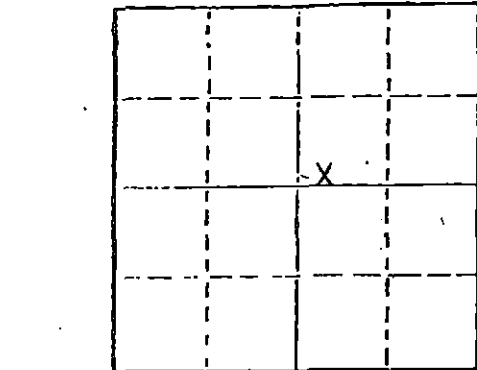

Locate well correctly on above  
Section Plat

Name of Conservation Agent who supervised plugging of this well Clarence Thomas  
Producing formation: Depth to top Bottom Total Depth of Well 13140'

Show depth and thickness of all water, oil and gas formations.

OIL, GAS OR WATER RECORDS

CASING RECORD

FORMATION	CONTENT	FROM	TO	SIZE	PUT IN	PULLED OUT
Council Grove	Dry	2966'	2982'	4 $\frac{1}{2}$ "	3145'	1558'

Describe in detail the manner in which the well was plugged, indicating where the mud fluid was placed and the method or methods used in introducing it into the hold. If cement or other plugs were used, state the character of same and depth placed, from feet to feet for each plug set. Set GI BP @ 2900' KB. Dumped 1sx cmt on plug. Worked csg. free @ 1548' pulled up to 800'. Spotted 35 sx cmt plug from 705 to 800'. Pulled 4 $\frac{1}{2}$ " csg to 400' spotted 25 sx cmt plug from 332' to 400'. Finished pulling csg and spotted 10 sx cmt plug from 0' to 27'. Rec. total 38 jts. 4 $\frac{1}{2}$ " 9.5 csg. Cut off csg 3' below GL. Welded on cap w/company's name and date.

6-23-80

(If additional description is necessary, use BACK of this sheet)

Name of Plugging Contractor Sargent's Casing Pulling Company

STATE OF Oklahoma COUNTY OF Oklahoma, ss.  
H. E. Massey (employee of ~~XXXXXX~~ operator)  
of the above-described well, being first duly sworn on oath, says: That I have knowledge of the facts, statements, and matters herein contained and the log of the above-described well as filed and that the same are true and correct. So help me God.

(Signature) H. E. Massey H. E. Massey  
3545 N.W. 58th Street, Okla. City, OK 73112  
(Address)

SUBSCRIBED AND SWORN TO before me this 18th day of June, 1980

Joyce S. Darter  
Joyce S. Darter Notary Public.

My commission expires 6-10-84